


T.4S.R.5W.W.M.

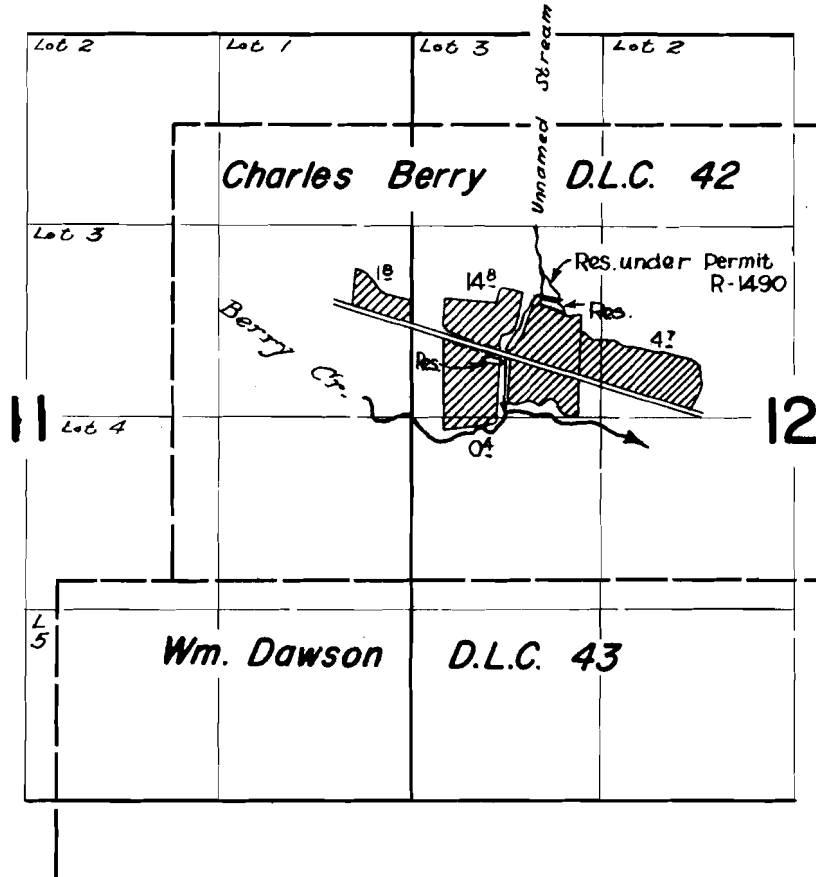

FINAL PROOF SURVEY
UNDER

R-33102 R-2243
Application No. 33103 Permit No. 26168
IN NAME OF

CARTER & HELEN KVAVLE

Surveyed August 28 1962, by *[Signature]*