

FINAL PROOF SURVEY

UNDER


Application 34771 Permit 27293

IN NAME OF

LOWELL M. NEWMAN

Surveyed July 24 & Sept. 7, 1962

by R. H. Jackson

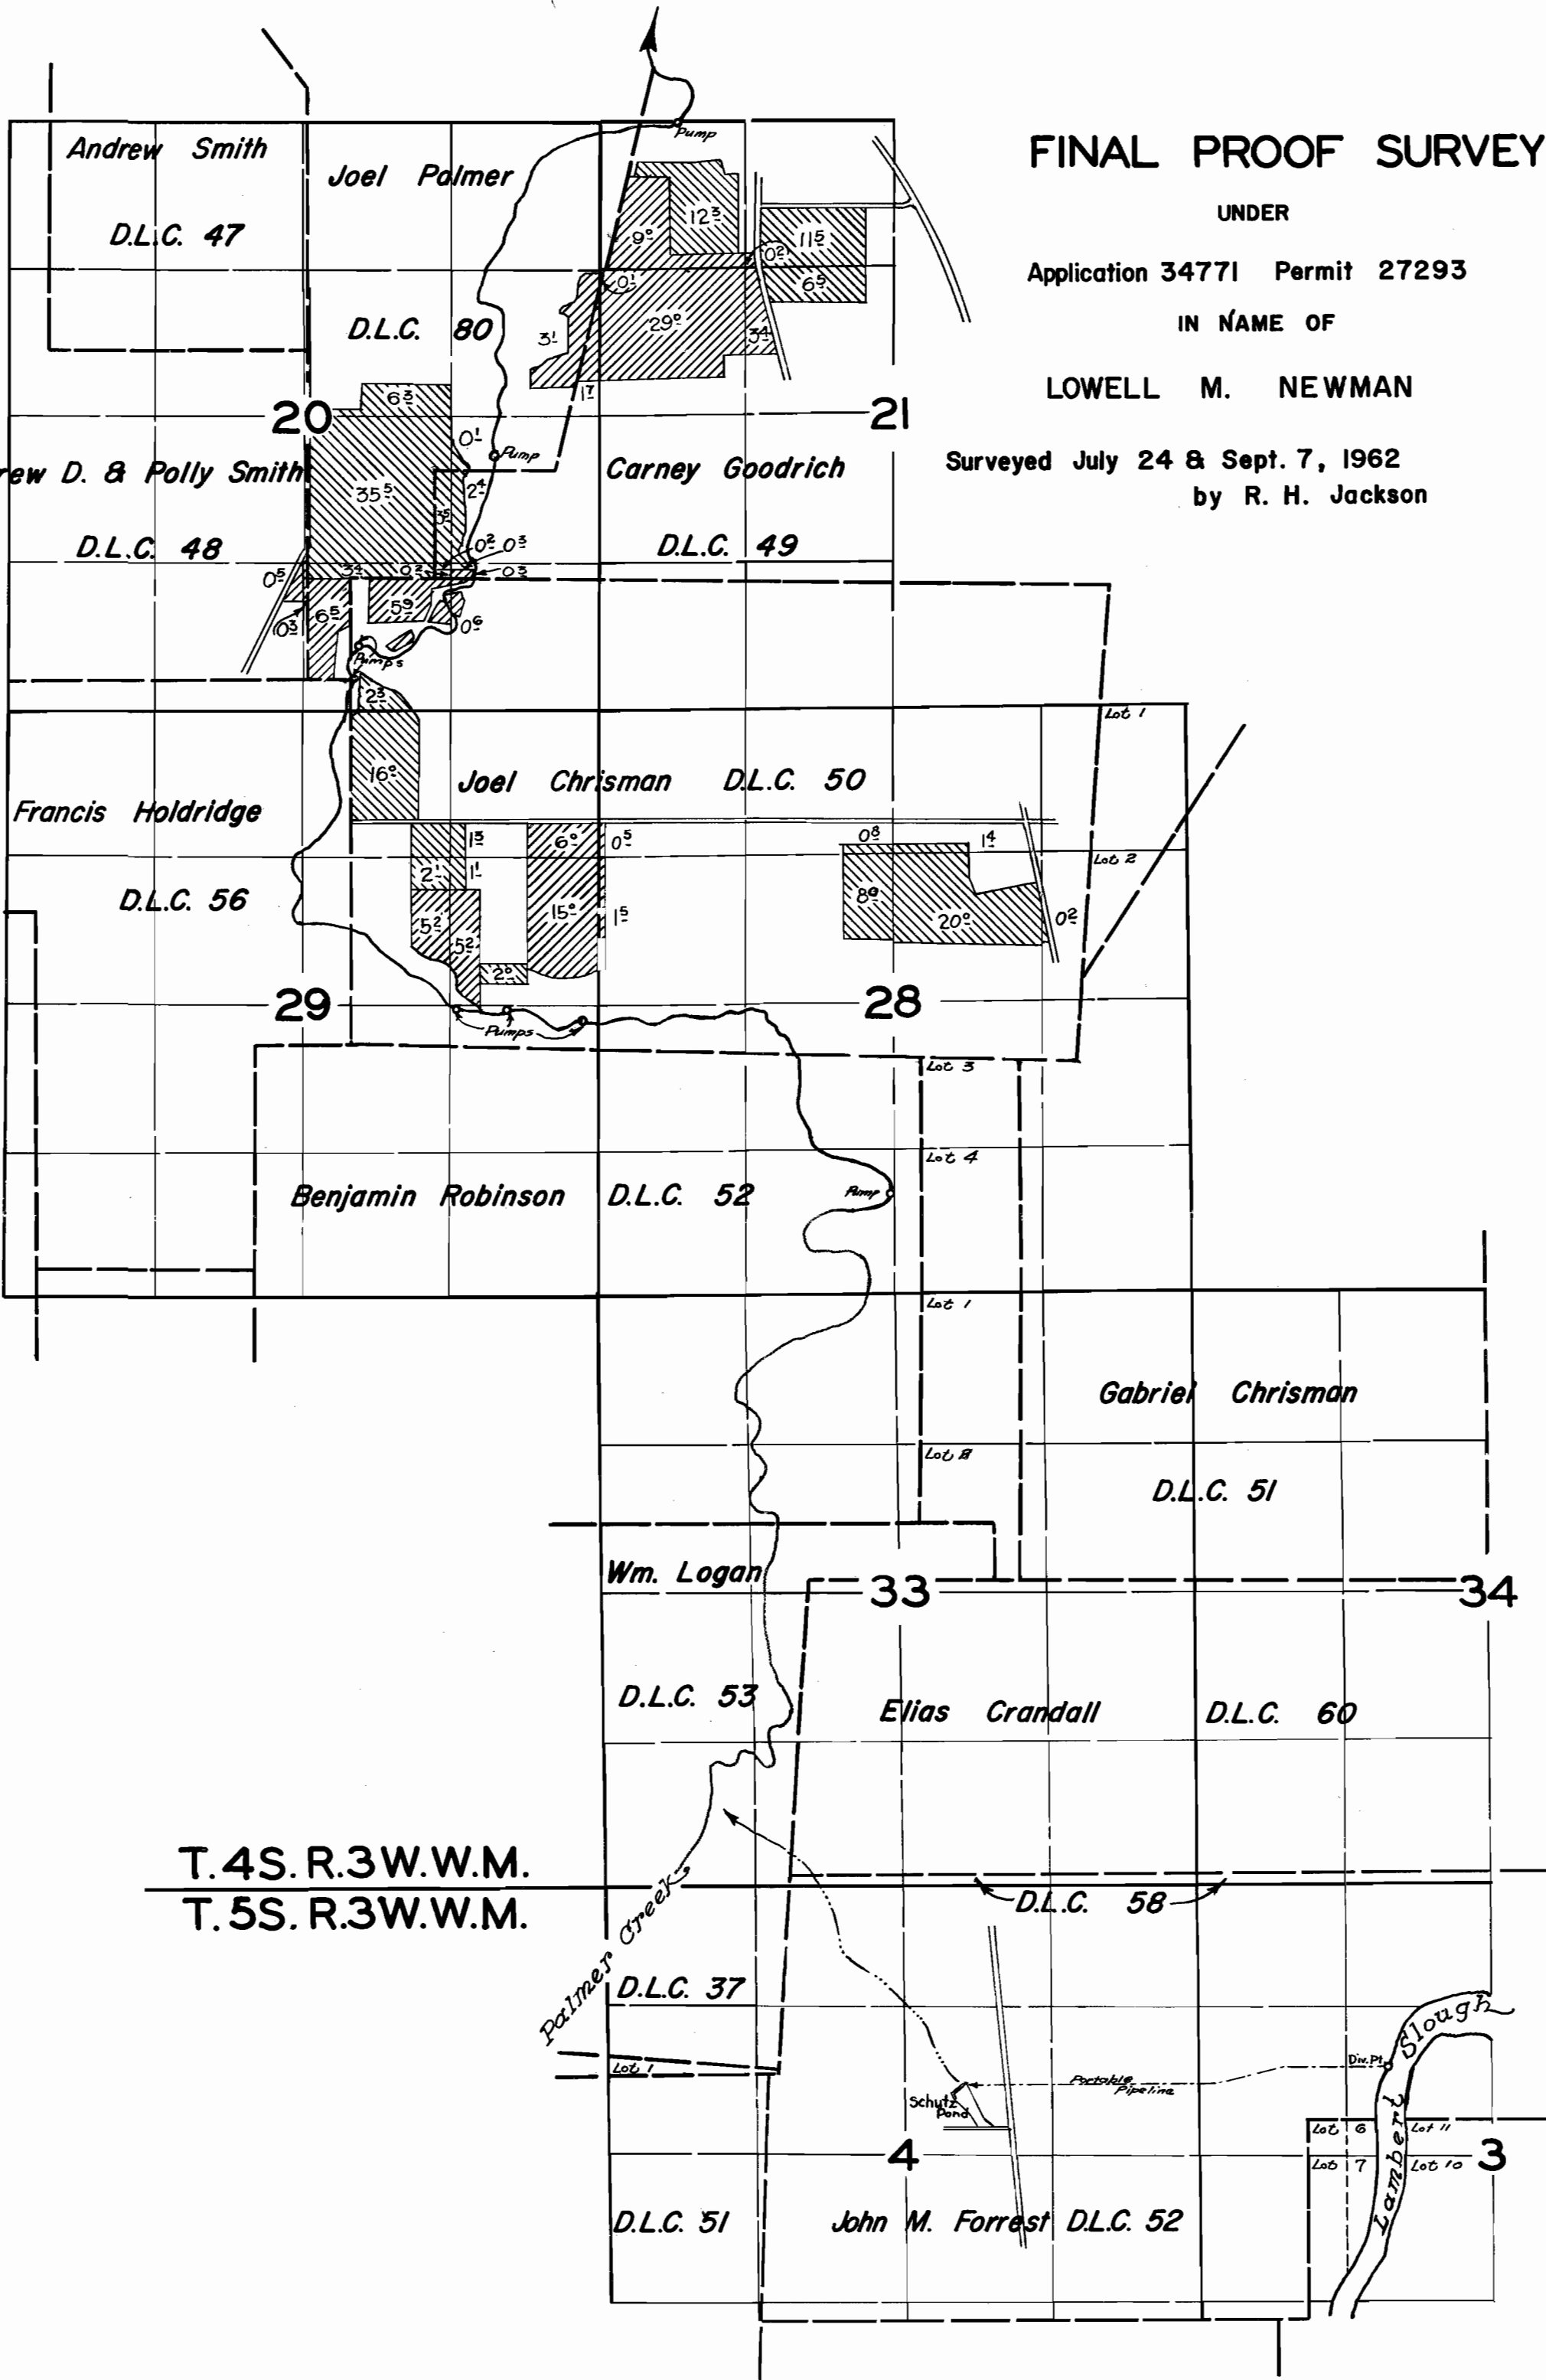

Andrew Smith
D.L.C. 47

Joel Palmer

D.L.C. 80

Carney Goodrich

D.L.C. 49

Andrew D. & Polly Smith

D.L.C. 48

Francis Holdridge

D.L.C. 56

Joel Chrisman D.L.C. 50

Benjamin Robinson D.L.C. 52

Gabriel Chrisman

D.L.C. 51

Wm. Logan

D.L.C. 53

Elias Crandall

D.L.C. 60

T.4S. R.3W.W.M.
T.5S. R.3W.W.M.

D.L.C. 37

D.L.C. 51

John M. Forrest D.L.C. 52

D.L.C. 58

Lot 6
Lot 7
Lot 10
Lot 11