


T.4S.R.3W.W.M.

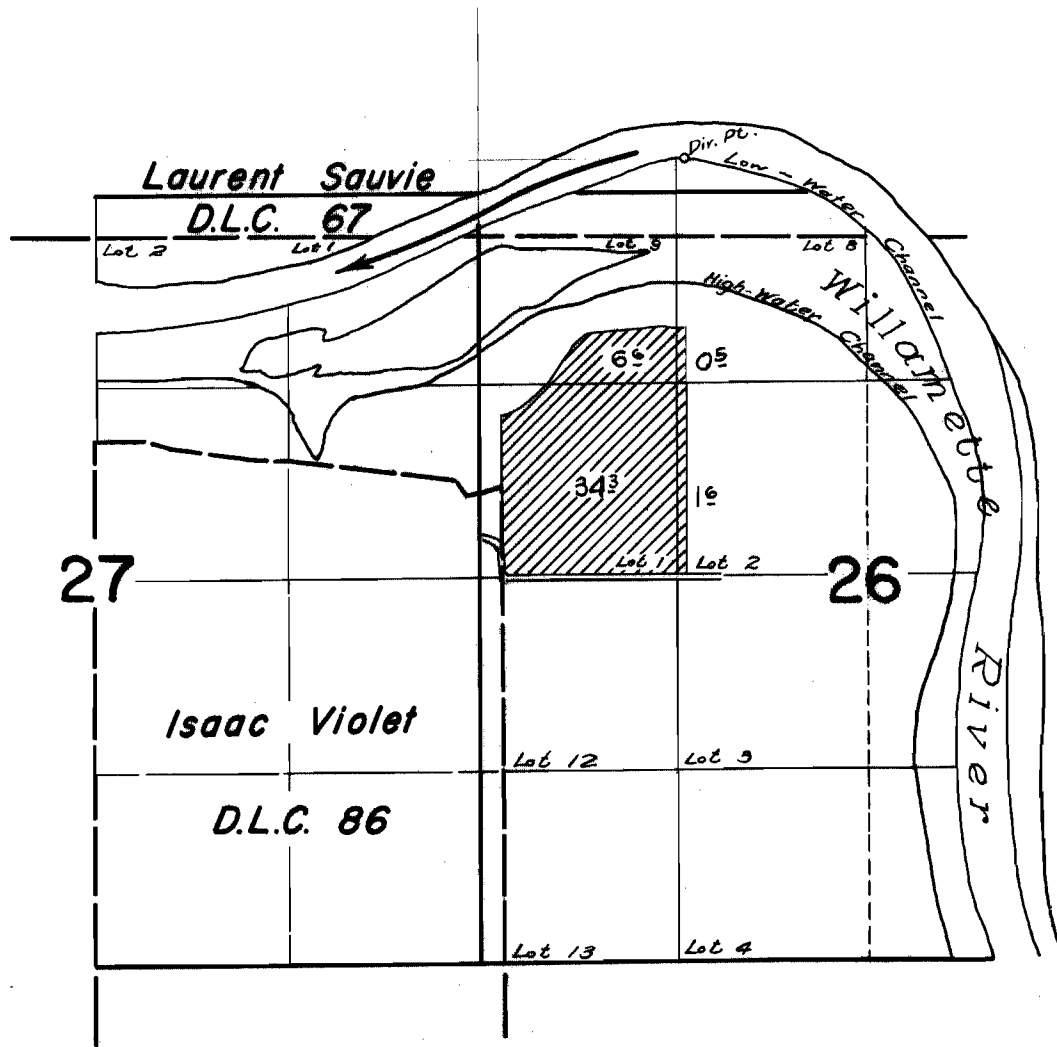

FINAL PROOF SURVEY
UNDER

Application No. 33936 Permit No. 26757
IN NAME OF

ELISE LONDERSHAUSEN

Surveyed July 19, 1962, by [Signature]