


T. 48 & 5 S. R. 3 W. W.M.

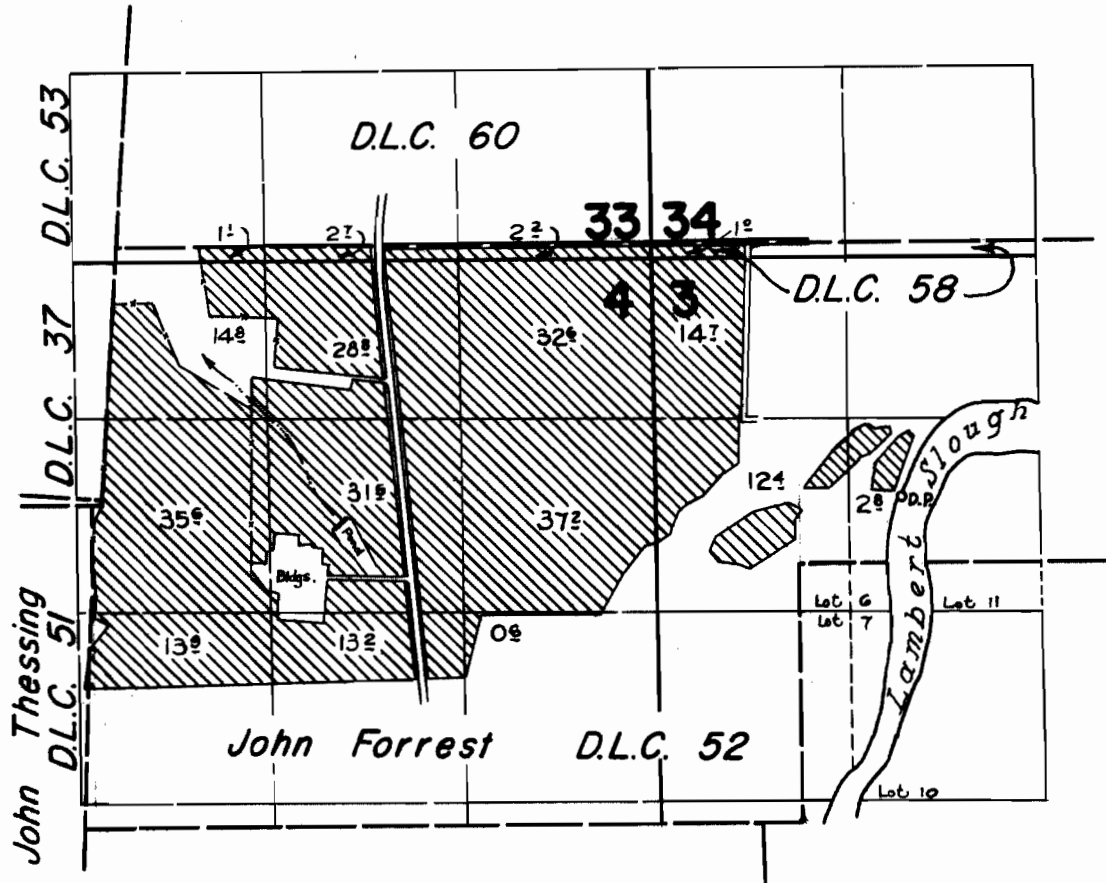

**FINAL PROOF SURVEY**  
UNDER

Application No. 31357..... Permit No. 24703.....  
IN NAME OF

.....ADOLPH E. SCHUTZ.....

Surveyed July 20 & 23 1962, by *R. Jackson*