


T.7S.R.4W.W.M.

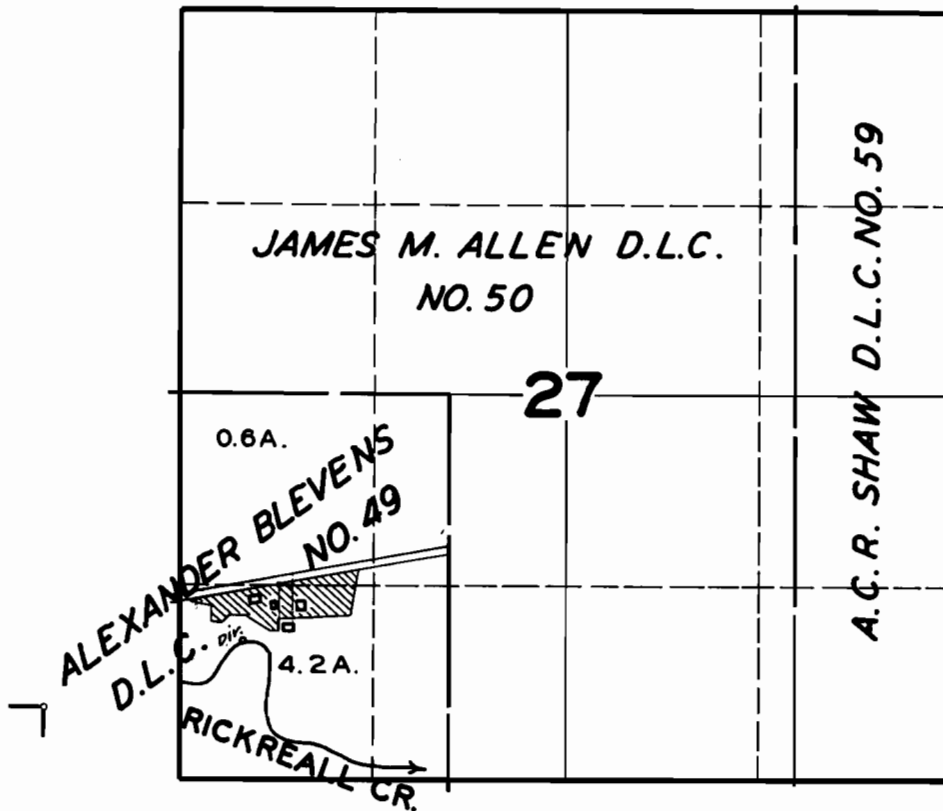

FINAL PROOF SURVEY
UNDER

Application No. **19522** Permit No. **15313**
IN NAME OF

MRS. ELZA K. SPLANE

Surveyed **SEP. 2** 1948, by **JAS. E. BUNNELL**