


Twp. 13 S. R. 29 E. W.M.

Scale: 4" = 1 Mile

RECEIVED
NOV 13 1963
STATE ENGINEER
SALEM, O.

App. 8884
Per 5820

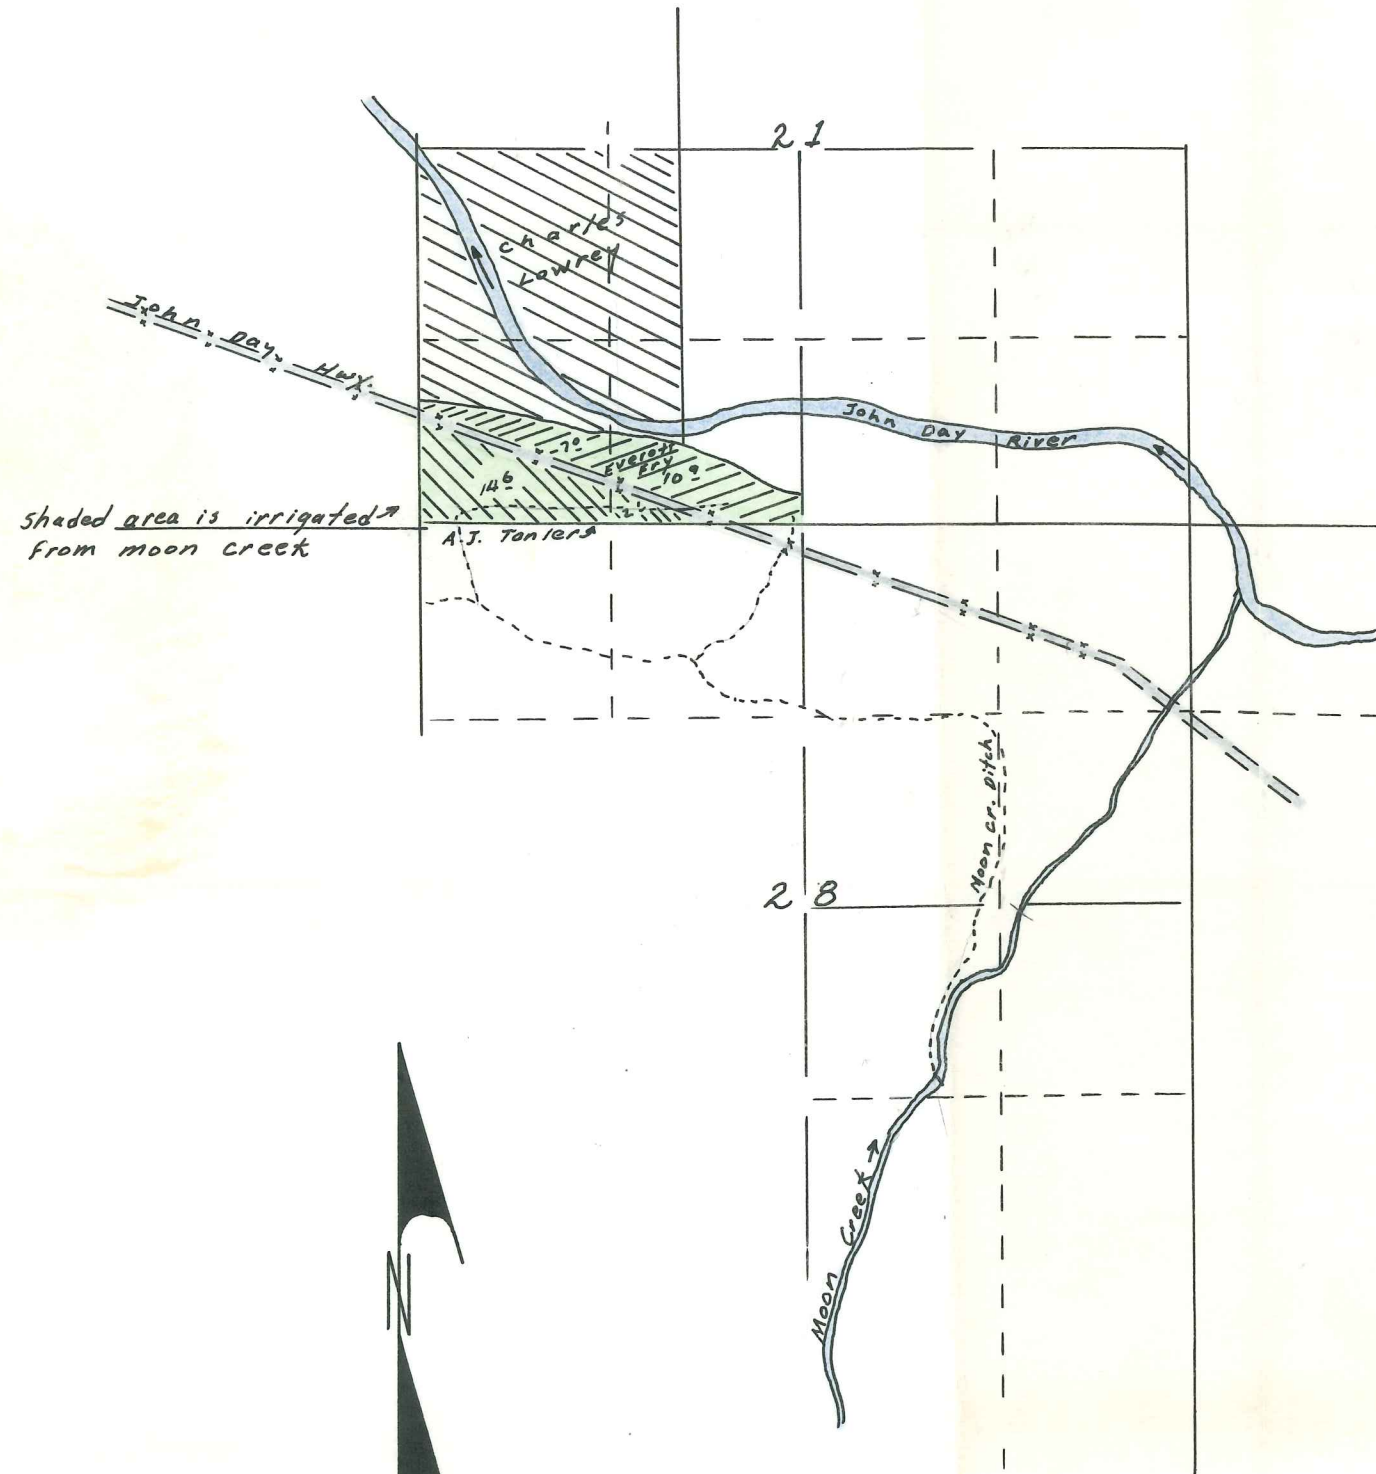

shaded area is irrigated
from moon creek

