


T.10S.R.4W.W.M.

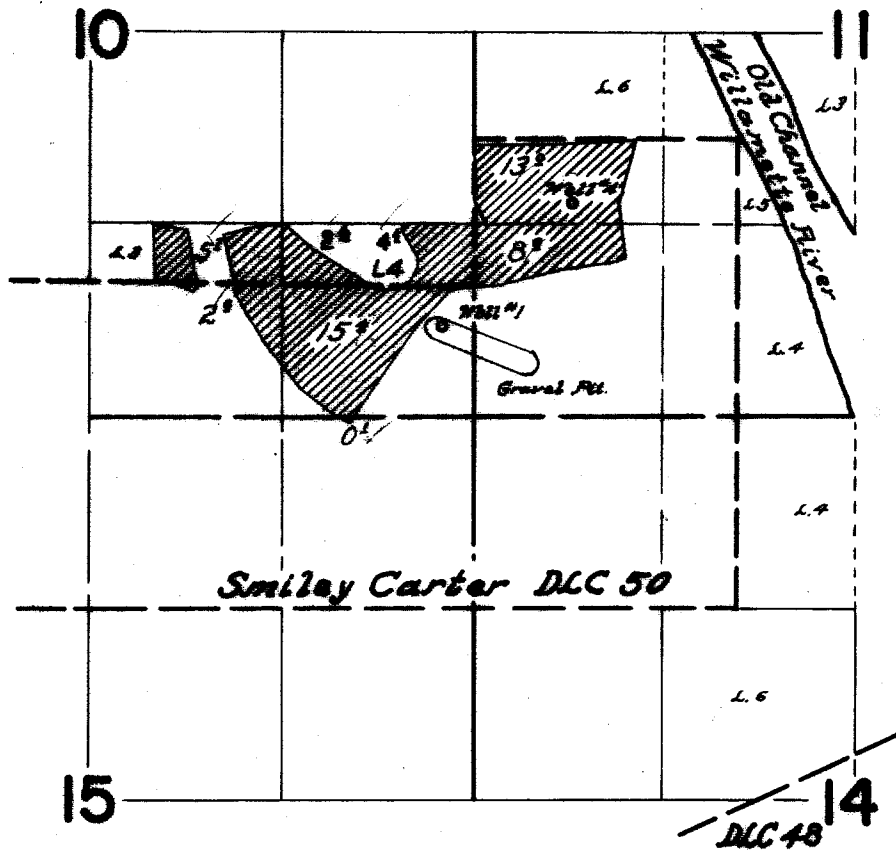

**FINAL PROOF SURVEY**  
UNDER

Application No. *G-1908* Permit No. *G-1746*  
IN NAME OF

*Kenneth Holmes*

Surveyed *August 30 1962*, by *Thomas R. Lauer*