


T.26S.R.4W.W.M.

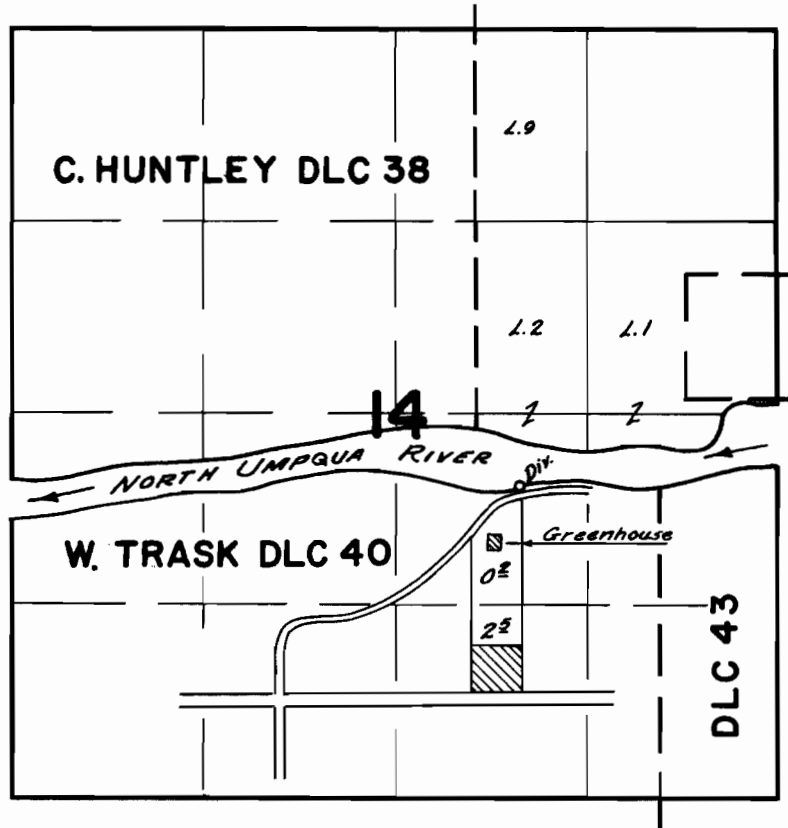

FINAL PROOF SURVEY
UNDER

Application No. 31276 Permit No. 24640
IN NAME OF

Howard V. & Grace Crook

Surveyed April 1 1963, by C.O. Bartels