


T.29S.R.8W.W.M.

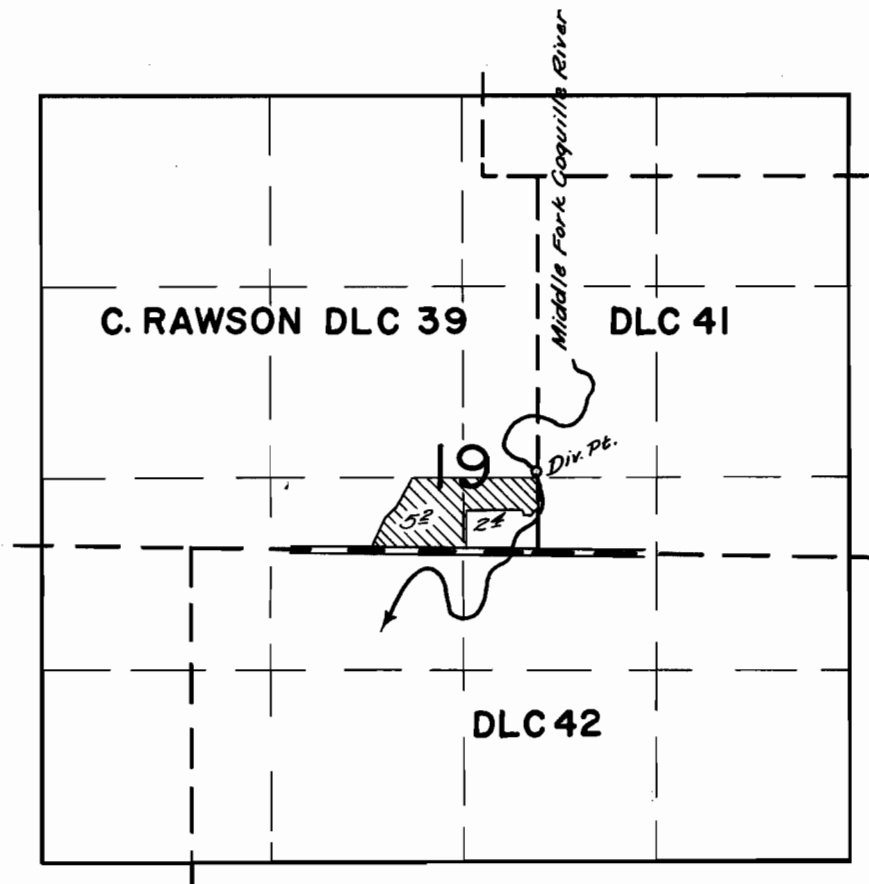

FINAL PROOF SURVEY
UNDER

Application No. 31621 Permit No. 25077
IN NAME OF

Ernest Wheeler

Surveyed April 3 1963, by C.O. Bartels