


T.27S.R.4W.W.M.

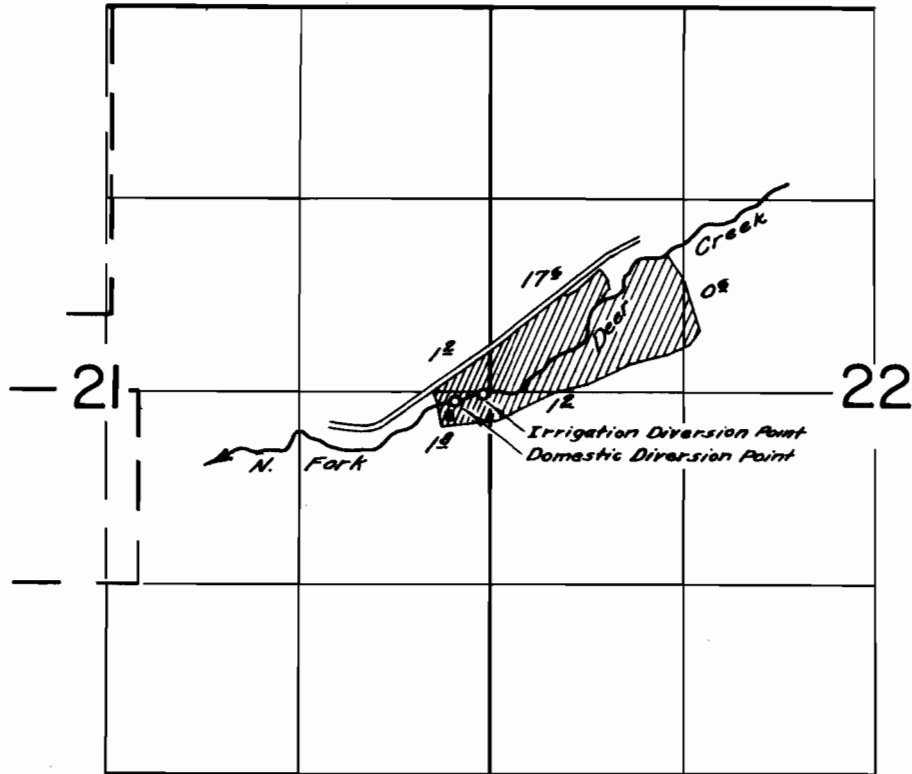

FINAL PROOF SURVEY
UNDER

Application No. 32032... Permit No. 25268...
IN NAME OF

.....**Emmitt Gibbons**.....

Surveyed May 20, 1963, by T. Lauer.....