


T.31S.R.3W.W.M.

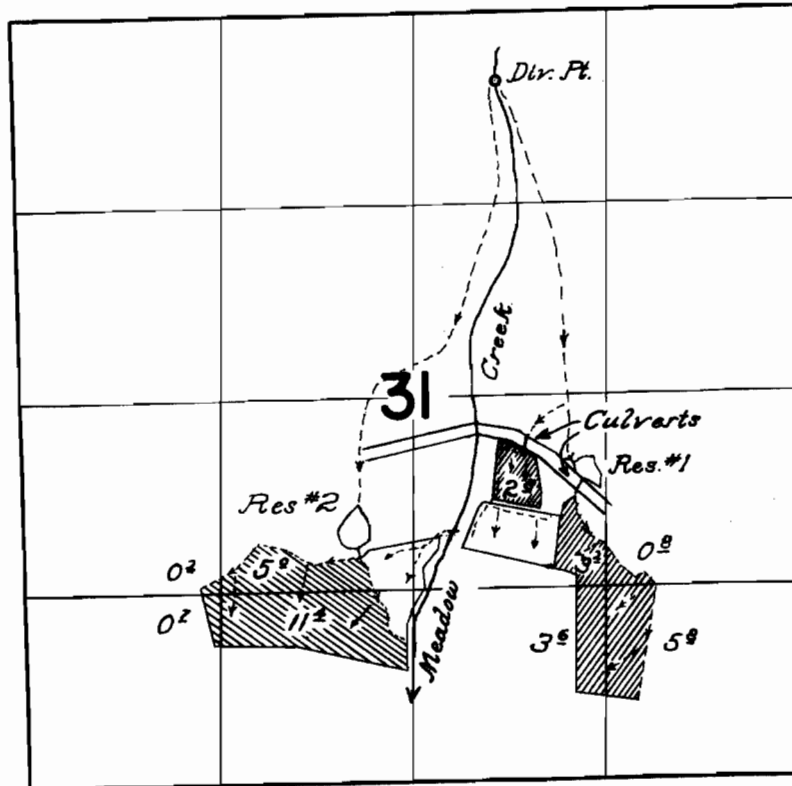



 Supplemental Primary

FINAL PROOF SURVEY

UNDER

R-32702

R-2197

32703

25834

R-32704

R-2198

Application No. 32705 Permit No. 25835

IN NAME OF

Henry L. & Eugina J. Matenstedt

Surveyed August 10, 1962, by Thomas R. Lauer