


T.27S.R.7W.W.M

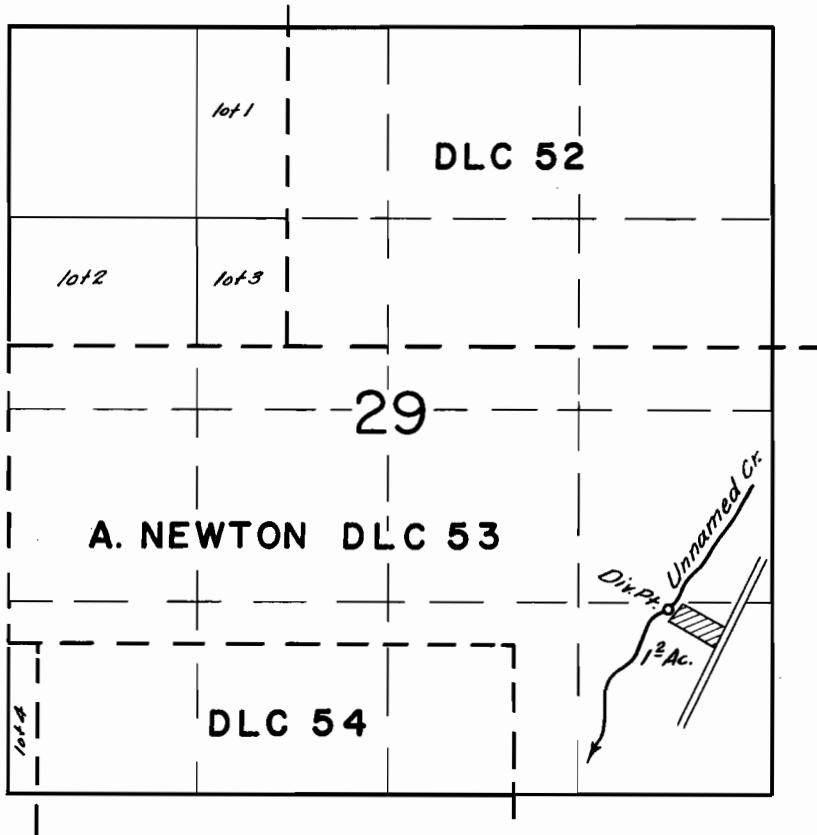

**FINAL PROOF SURVEY**  
UNDER

Application No. 32942 Permit No. 26063  
IN NAME OF

N.S. Atherton and E. I. Damewood

Surveyed April 3, 1963, by A. D. Bantler