


T.29S.R.5W.W.M.

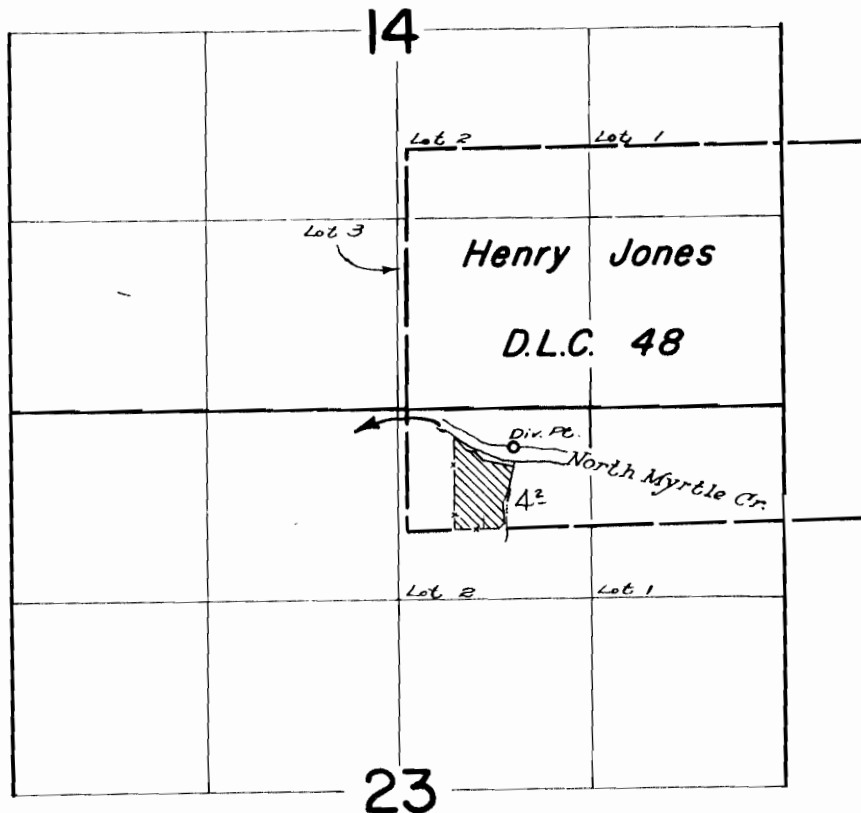

FINAL PROOF SURVEY
UNDER

Application No. **33100** Permit No. **26224**
IN NAME OF

JOHN O. WALIN

Surveyed August 6 1962, by *Alpekson*