


T.30S. R.4W.W.M.

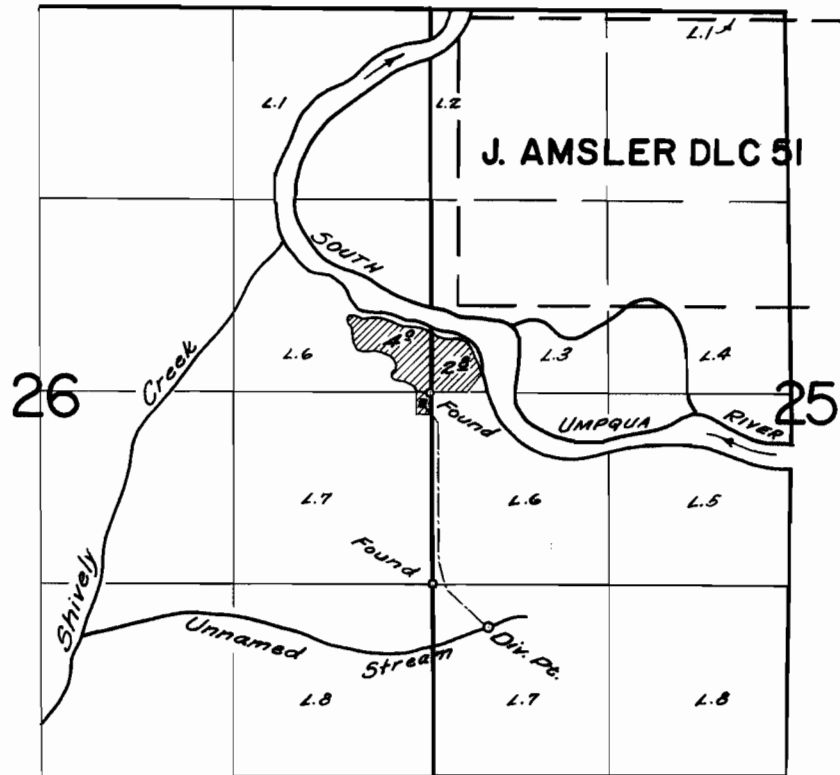

**FINAL PROOF SURVEY**  
UNDER

Application No. 33775 Permit No. 26666  
IN NAME OF

Albert T. McLind

Surveyed May 22 1963, by T. Lauer