


T.26S. R.3W.W.M.

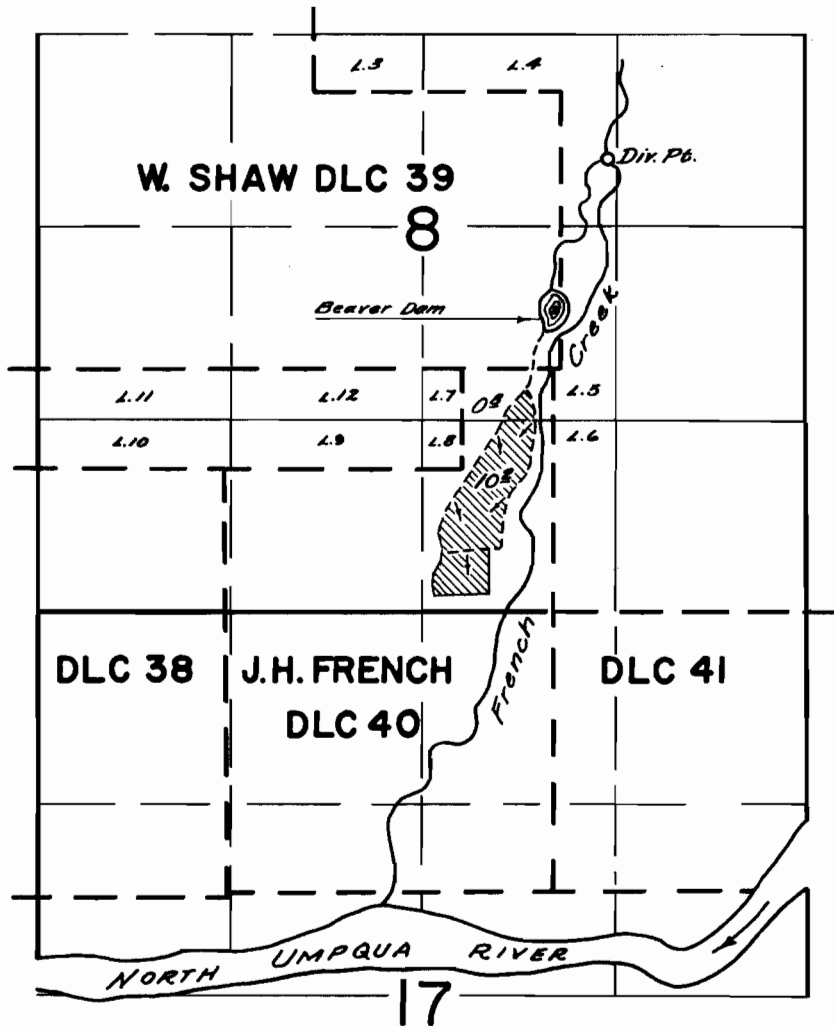

FINAL PROOF SURVEY
UNDER

Application No. 34940 Permit No. 27470
IN NAME OF

.....**Phil Strader**.....

Surveyed March 29 1963, by C.O. Bartals.....