


T.26S.R.7W.W.M.

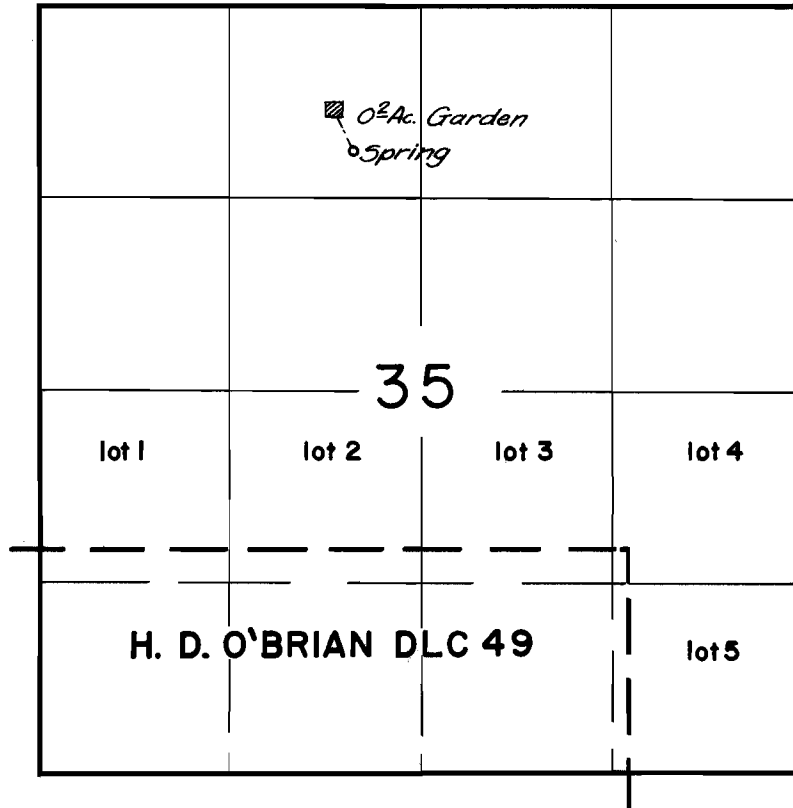

FINAL PROOF SURVEY
UNDER

Application No. 37323 Permit No. 27803
IN NAME OF

.....Richard H. Sommer.....

Surveyed March 27, 1963, by C.O. Bartels.....