


G-~~1561~~
1561

T. 2 N. R. 10 E. W.M.

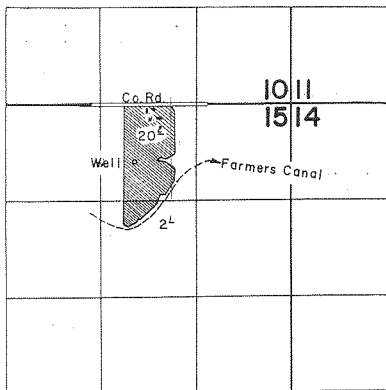

10/11/2001

Date Harris,
Current Owner,
60 ft was taken
from the East
side of this
property to make
a roadway and
added to parcel
to the East.

Take part of
overacreage off
here.

Watermaster
calculated a
60 foot strip
as 1 1/3 acres.
So there is still
about 1 1/3 acres
of overacreage
to locate.

Jerry Doll
Watermaster

Talked to Selam and from the file
description of Sump (shallow
infiltration trench) is 30 ft. by 50 ft.
by 4 ft deep - *WAT*
10/11/2001

FINAL PROOF SURVEY UNDER

Application No. G-1707, Permit No. G-1561.
IN NAME OF

ROBERT F. & NANCEY J. MOLLER

Surveyed July 3, 1962, by *W. J. Jelenc*