


T. 2 N. R. 10 E. W.M.

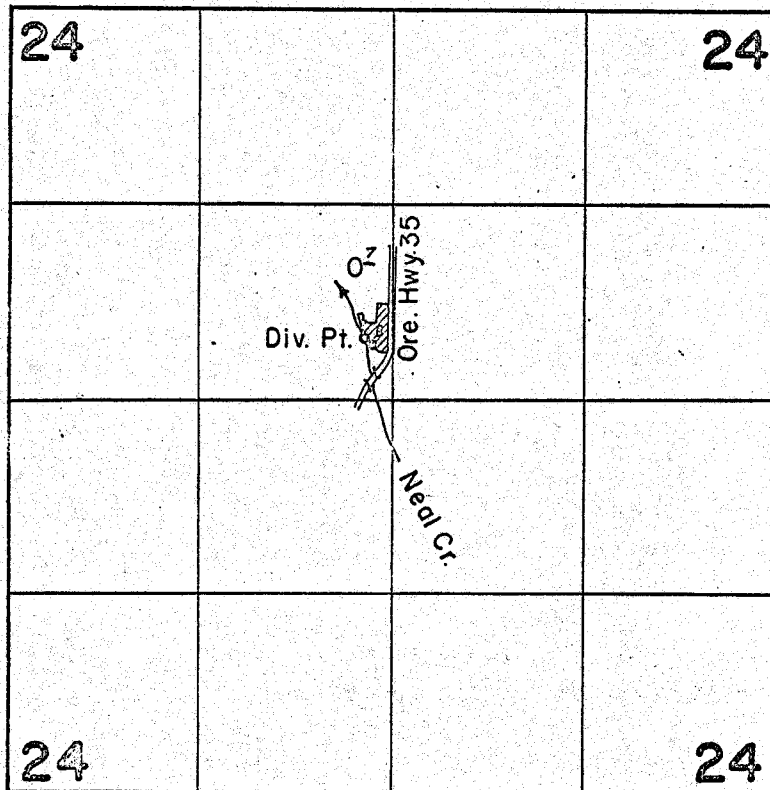

FINAL PROOF SURVEY
UNDER

Application No. 32404.. Permit No. 25585..
IN NAME OF

.....LYLE M. DILLENBECK.....

Surveyed July 3.... 1962, by *P. W. Jelousik*