


T. I. N. R. I. E. W. M.

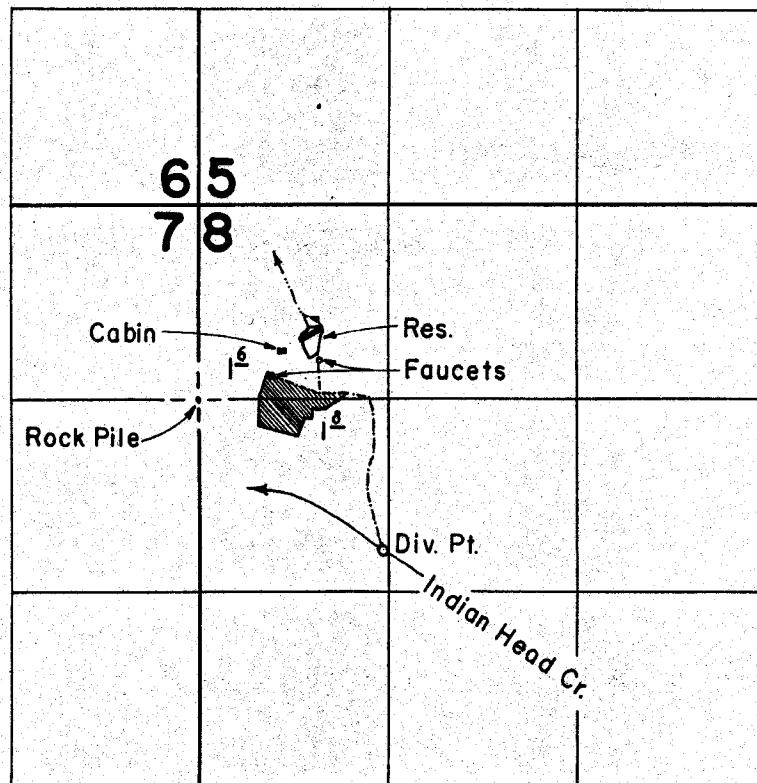

FINAL PROOF SURVEY

UNDER

R-32777 R-2203
 Application No. 32778 Permit No. 25863.
 IN NAME OF

JOHN B. LONG

Surveyed July 2, 1962, by *L. W. Johnson*