


T.2 N. R. 10E.W.M.

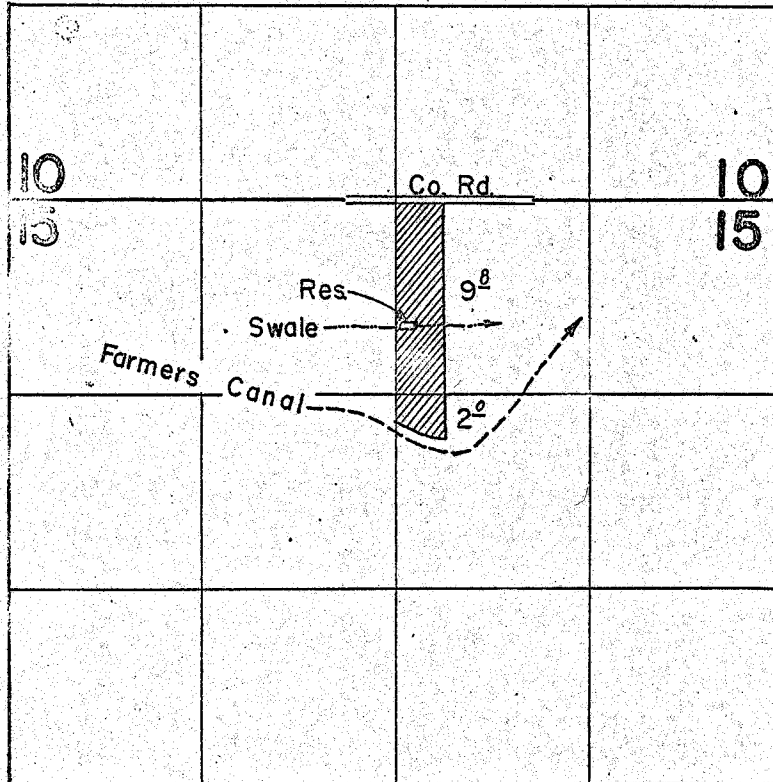

FINAL PROOF SURVEY UNDER

R-33118 R-2253
 Application No. 33119 Permit No. 26225
 IN NAME OF

.....ROBERT MERTON KAHLER.....

Surveyed July 3... 1962, by *d.w. Gebusek*