


T. 2 N. R. 10 E. W.M.

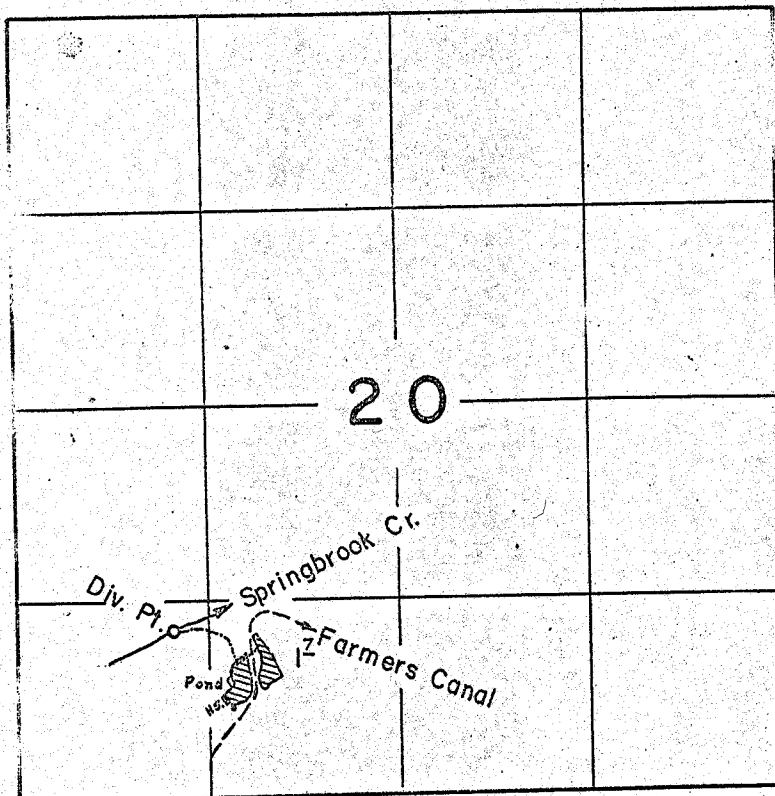

FINAL PROOF SURVEY
UNDER

Application No. 34228... Permit No. 26997...
IN NAME OF

CHAS. O'BRIEN

Surveyed July... 5... 1962, by *L.W. Jelousek*