


T. 40 S. R. 4 W.W.M.

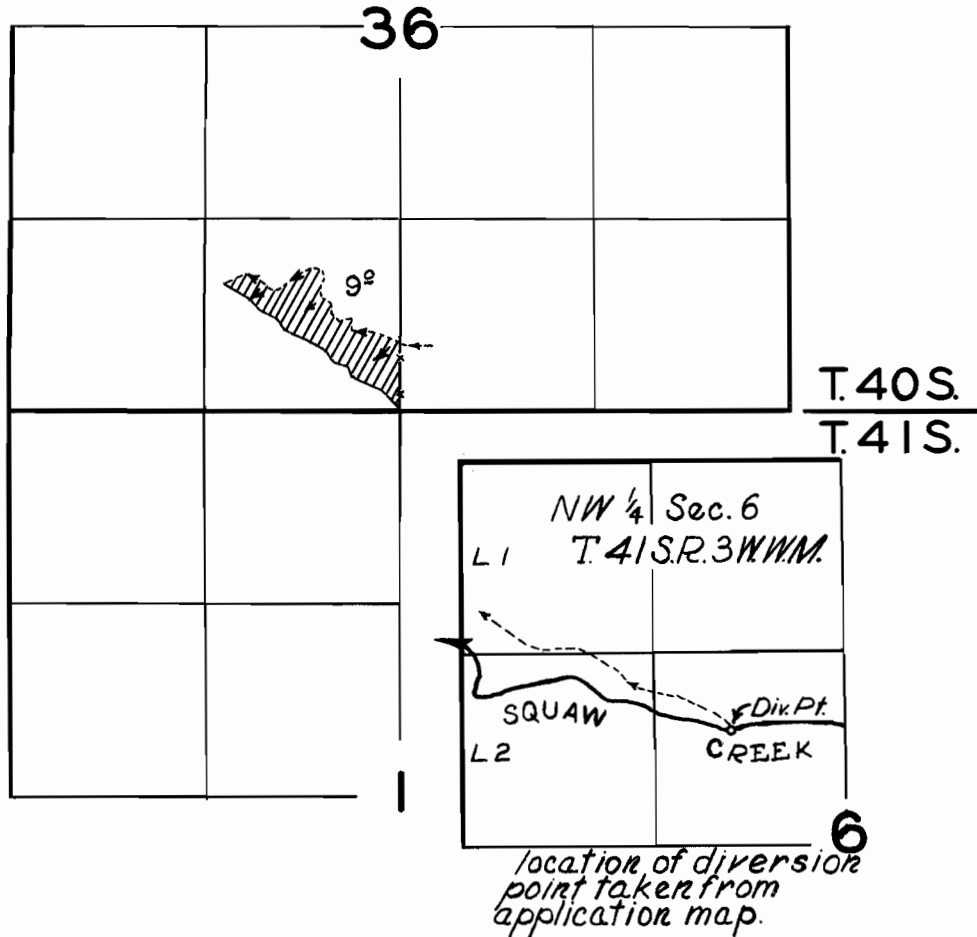

FINAL PROOF SURVEY
UNDER

R-28239 R-2205
Application No. 28240 Permit No. 25879
IN NAME OF

C. H. ROLOFF

Surveyed April, 17, 1962, by C.R. Baker