
T.35S.R.14E.W.M.

T.36S.R.14E.W.M.

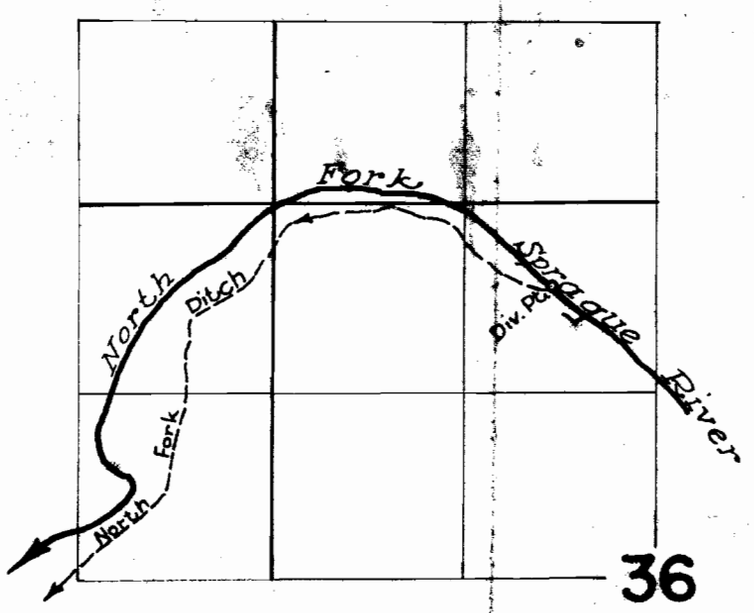


NORTH FORK DIVERSION LOCATION
From Adjudication Map




# FINAL PROOF SURVEY

UNDER

| | | | |
|---|---|---|---|
| Application | 25527 | Permit | 23741 |
| | R-28647 | | R-1553 |
| | 28648 | | 22565 |
| | 30526 | | 24036 |

IN NAME OF

FREDERICK W. & ELIZABETH H. HYDE

Surveyed August 15-16, 1962 by K.H. Jackson

1962-N
CNO-75K-52¢ 79K-20