



T. 35S. R. 14 E. W. M.

T. 36S. R. 14 E. W. M.

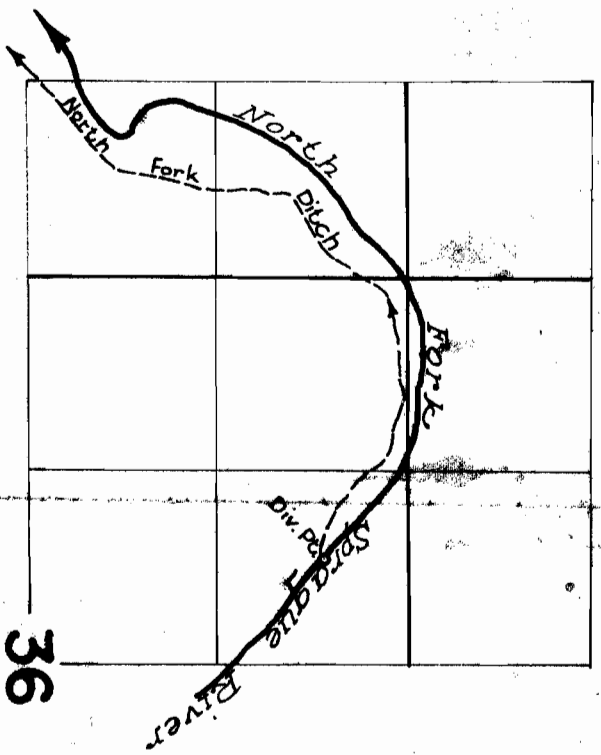

NORTH FORK DIVERSION LOCATION
From Adjudication Map

36

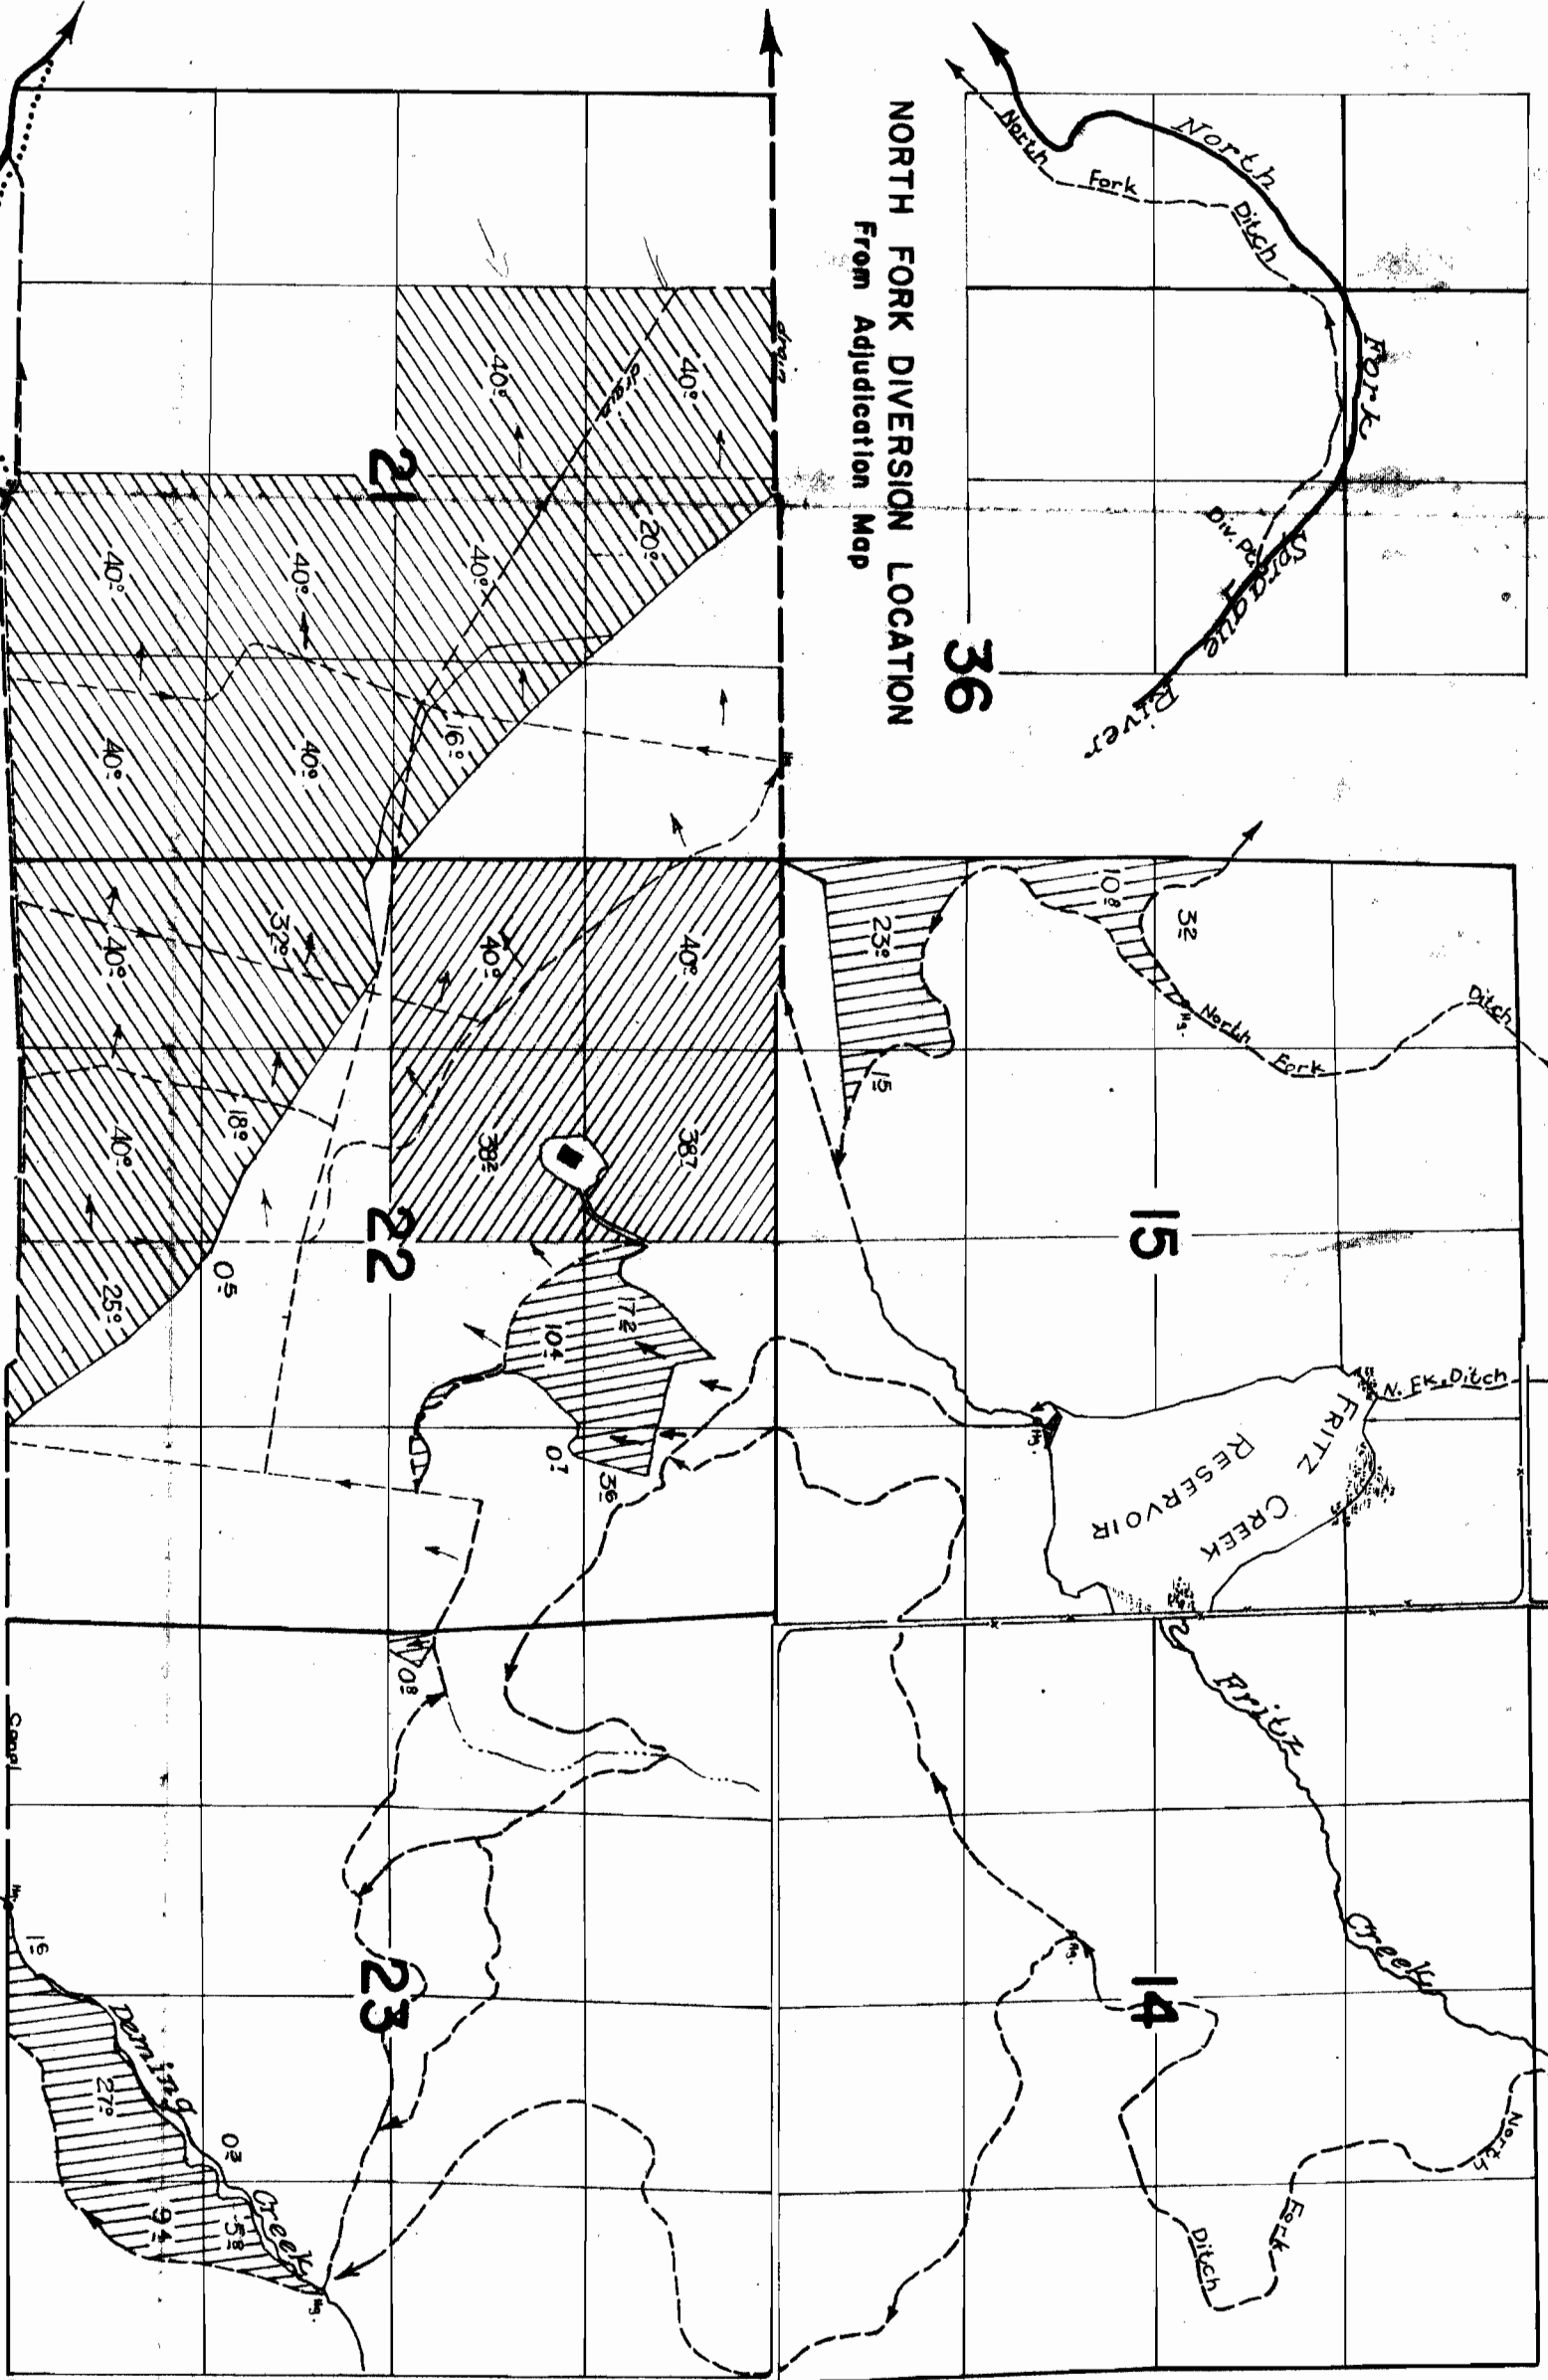

FINAL PROOF SURVEY

UNDER

Application 25527 Permit 23741

R-28647 R-1553

28648 22565

30526 24036

IN NAME OF



FREDERICK W. & ELIZABETH H. HYDE
Surveyed August 15-16, 1962 by *F. W. Hyde*