

T.35S.R.14E.W.M.


FINAL PROOF SURVEY

UNDER
Application No. 30526 Permit No. **24036**

IN NAME OF
TOTTSIE W. J. LORENZ

Surveyed May 26, 1964 by *L. Jackson*

CND-75K-52

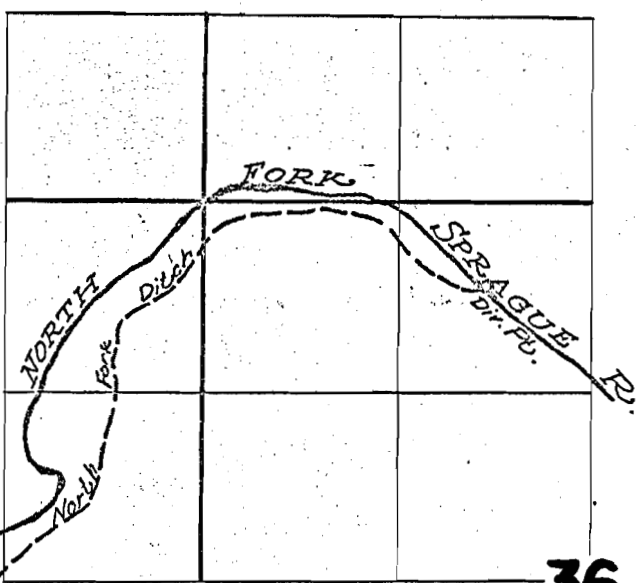

NORTH FORK DIVERSION 36
From Adjudication Map

T.36S.R.14E.W.M. See Also Permit 23741

N. Ste. Sprague Co. Map.

