


T.35S.R.14E.W.M.

T.36S.R.14E.W.M.

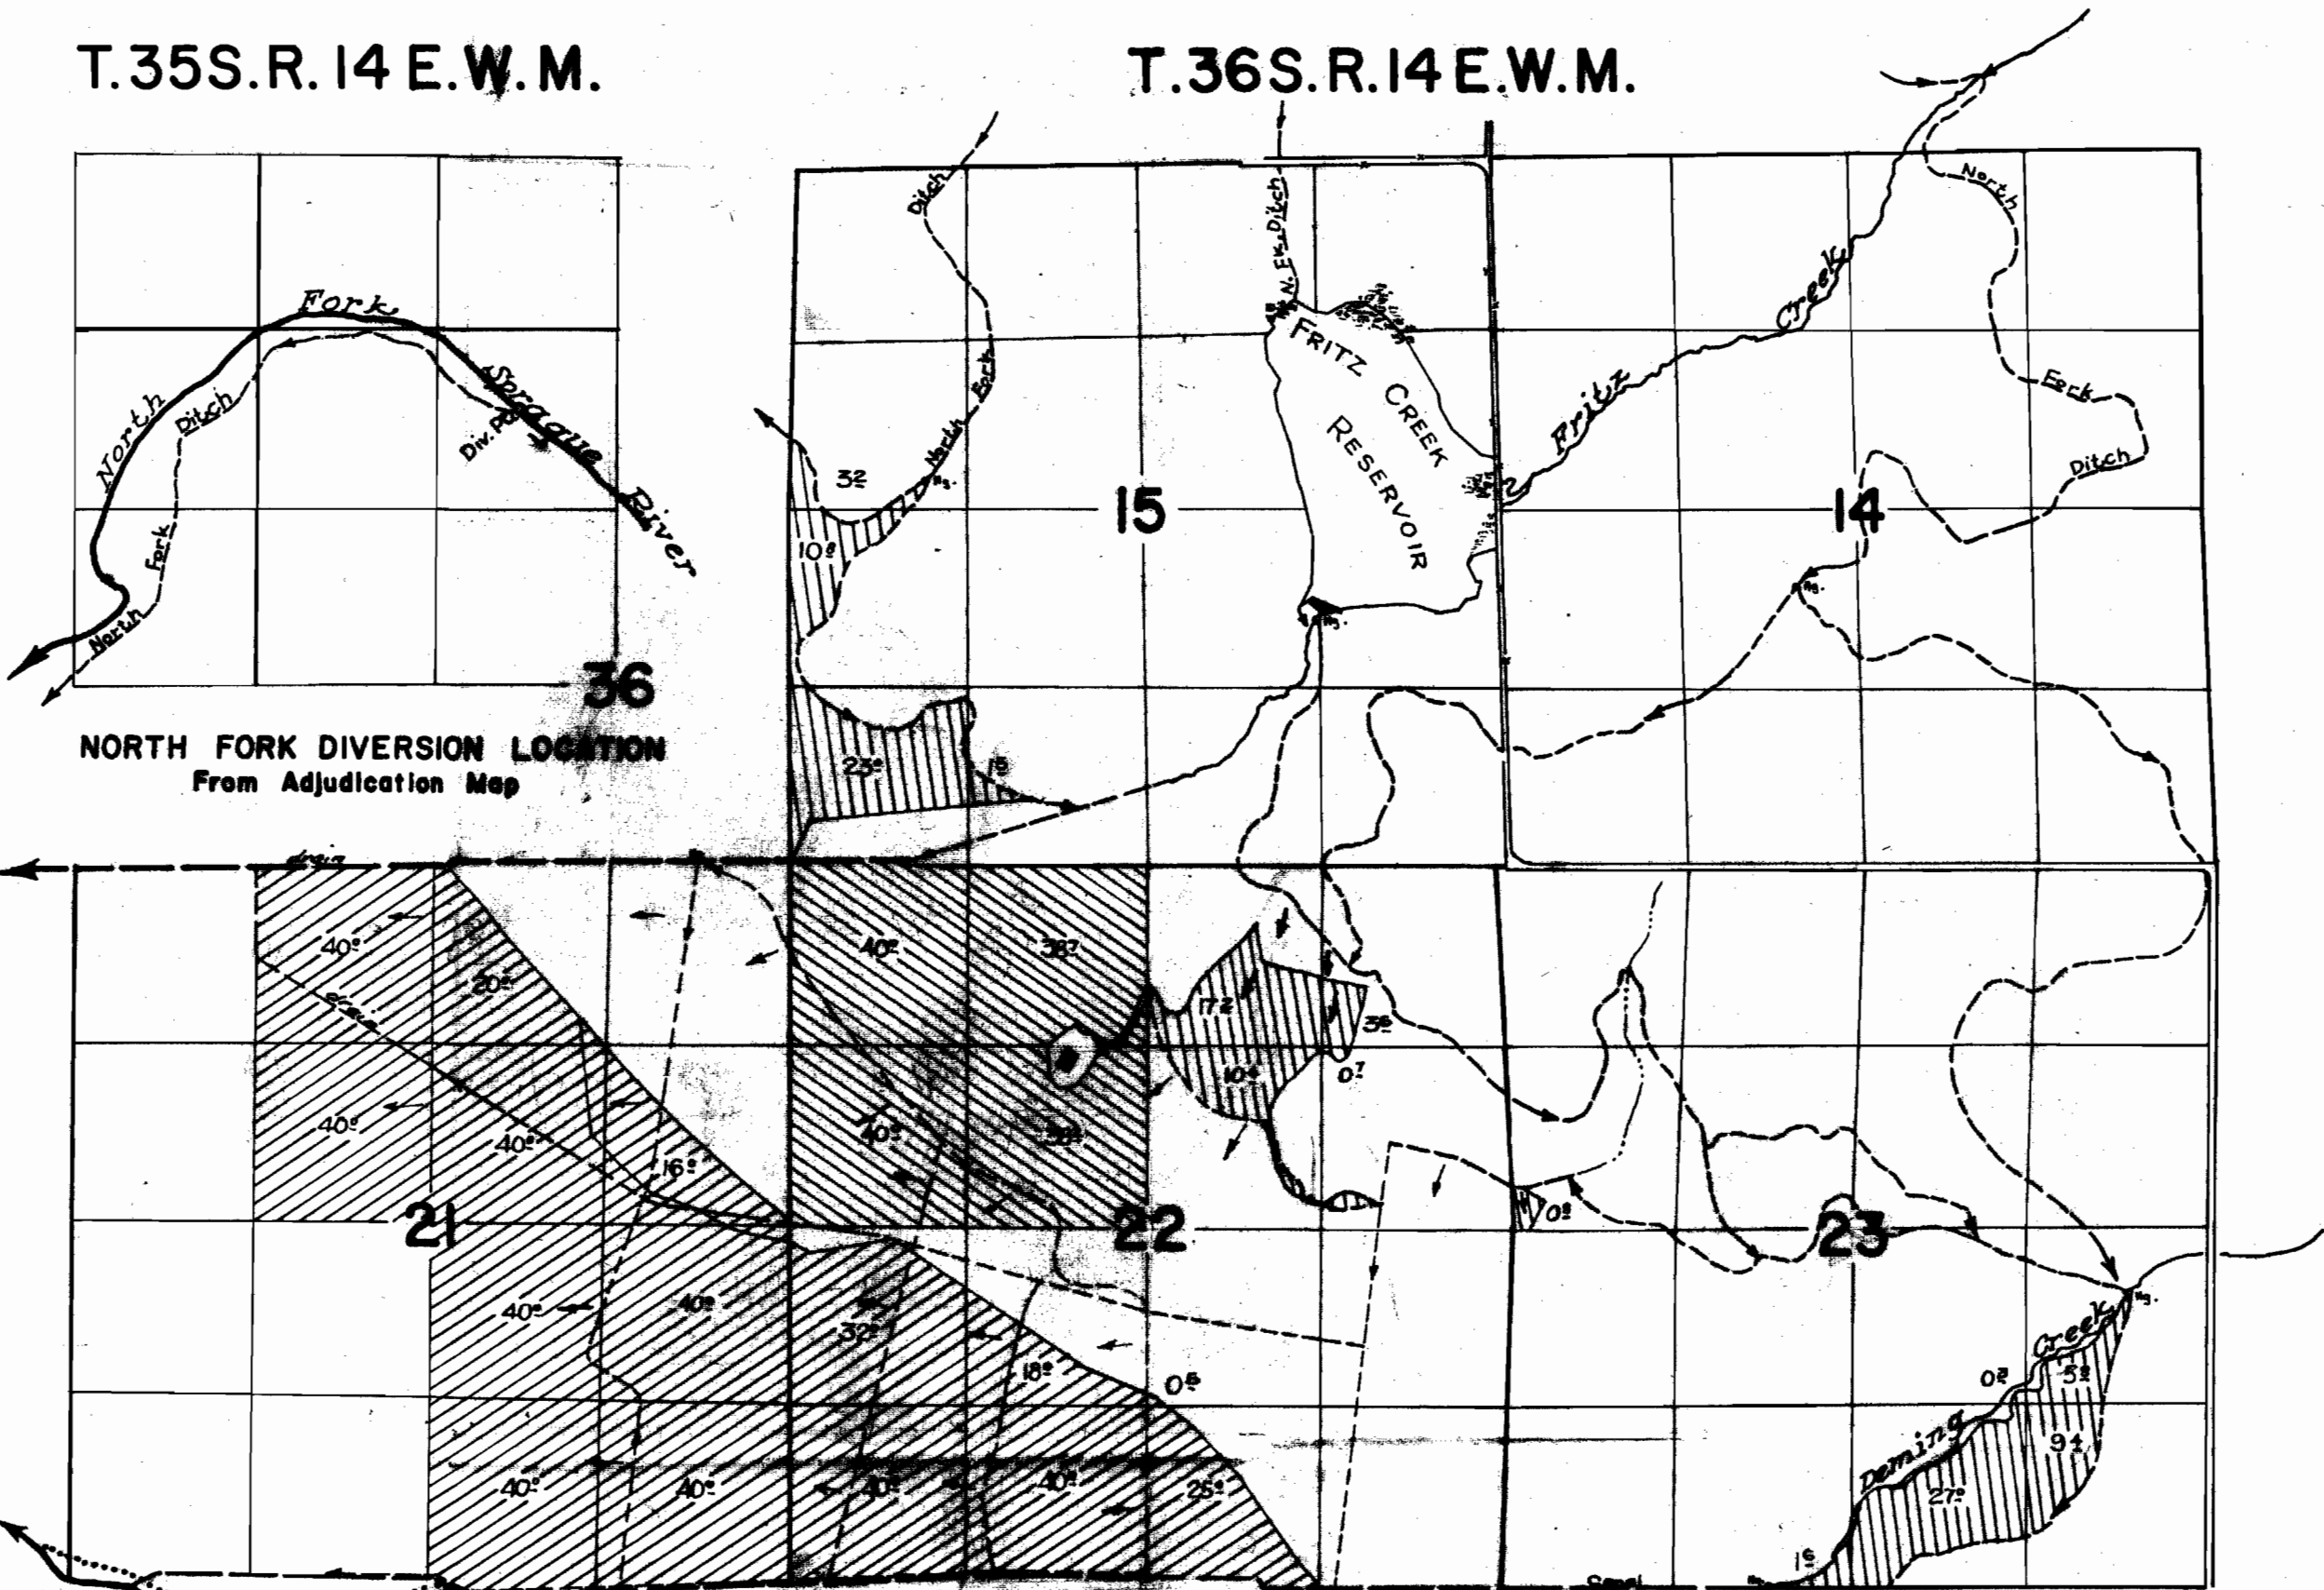

NORTH FORK DIVERSION LOCATION
From Adjudication Map

Old Channel
South Fork Sprague R.
Relocated Channel

FINAL PROOF SURVEY

UNDER

Application 25527 Permit 23741

R-28647 R-1553

28648 22565

30526 24036


IN NAME OF

FREDERICK W. & ELIZABETH H. HYDE

Surveyed August 15-16, 1962 by *H. Nelson*

T.35S.R.14E.W.M.

T.36S.R.14E.W.M.

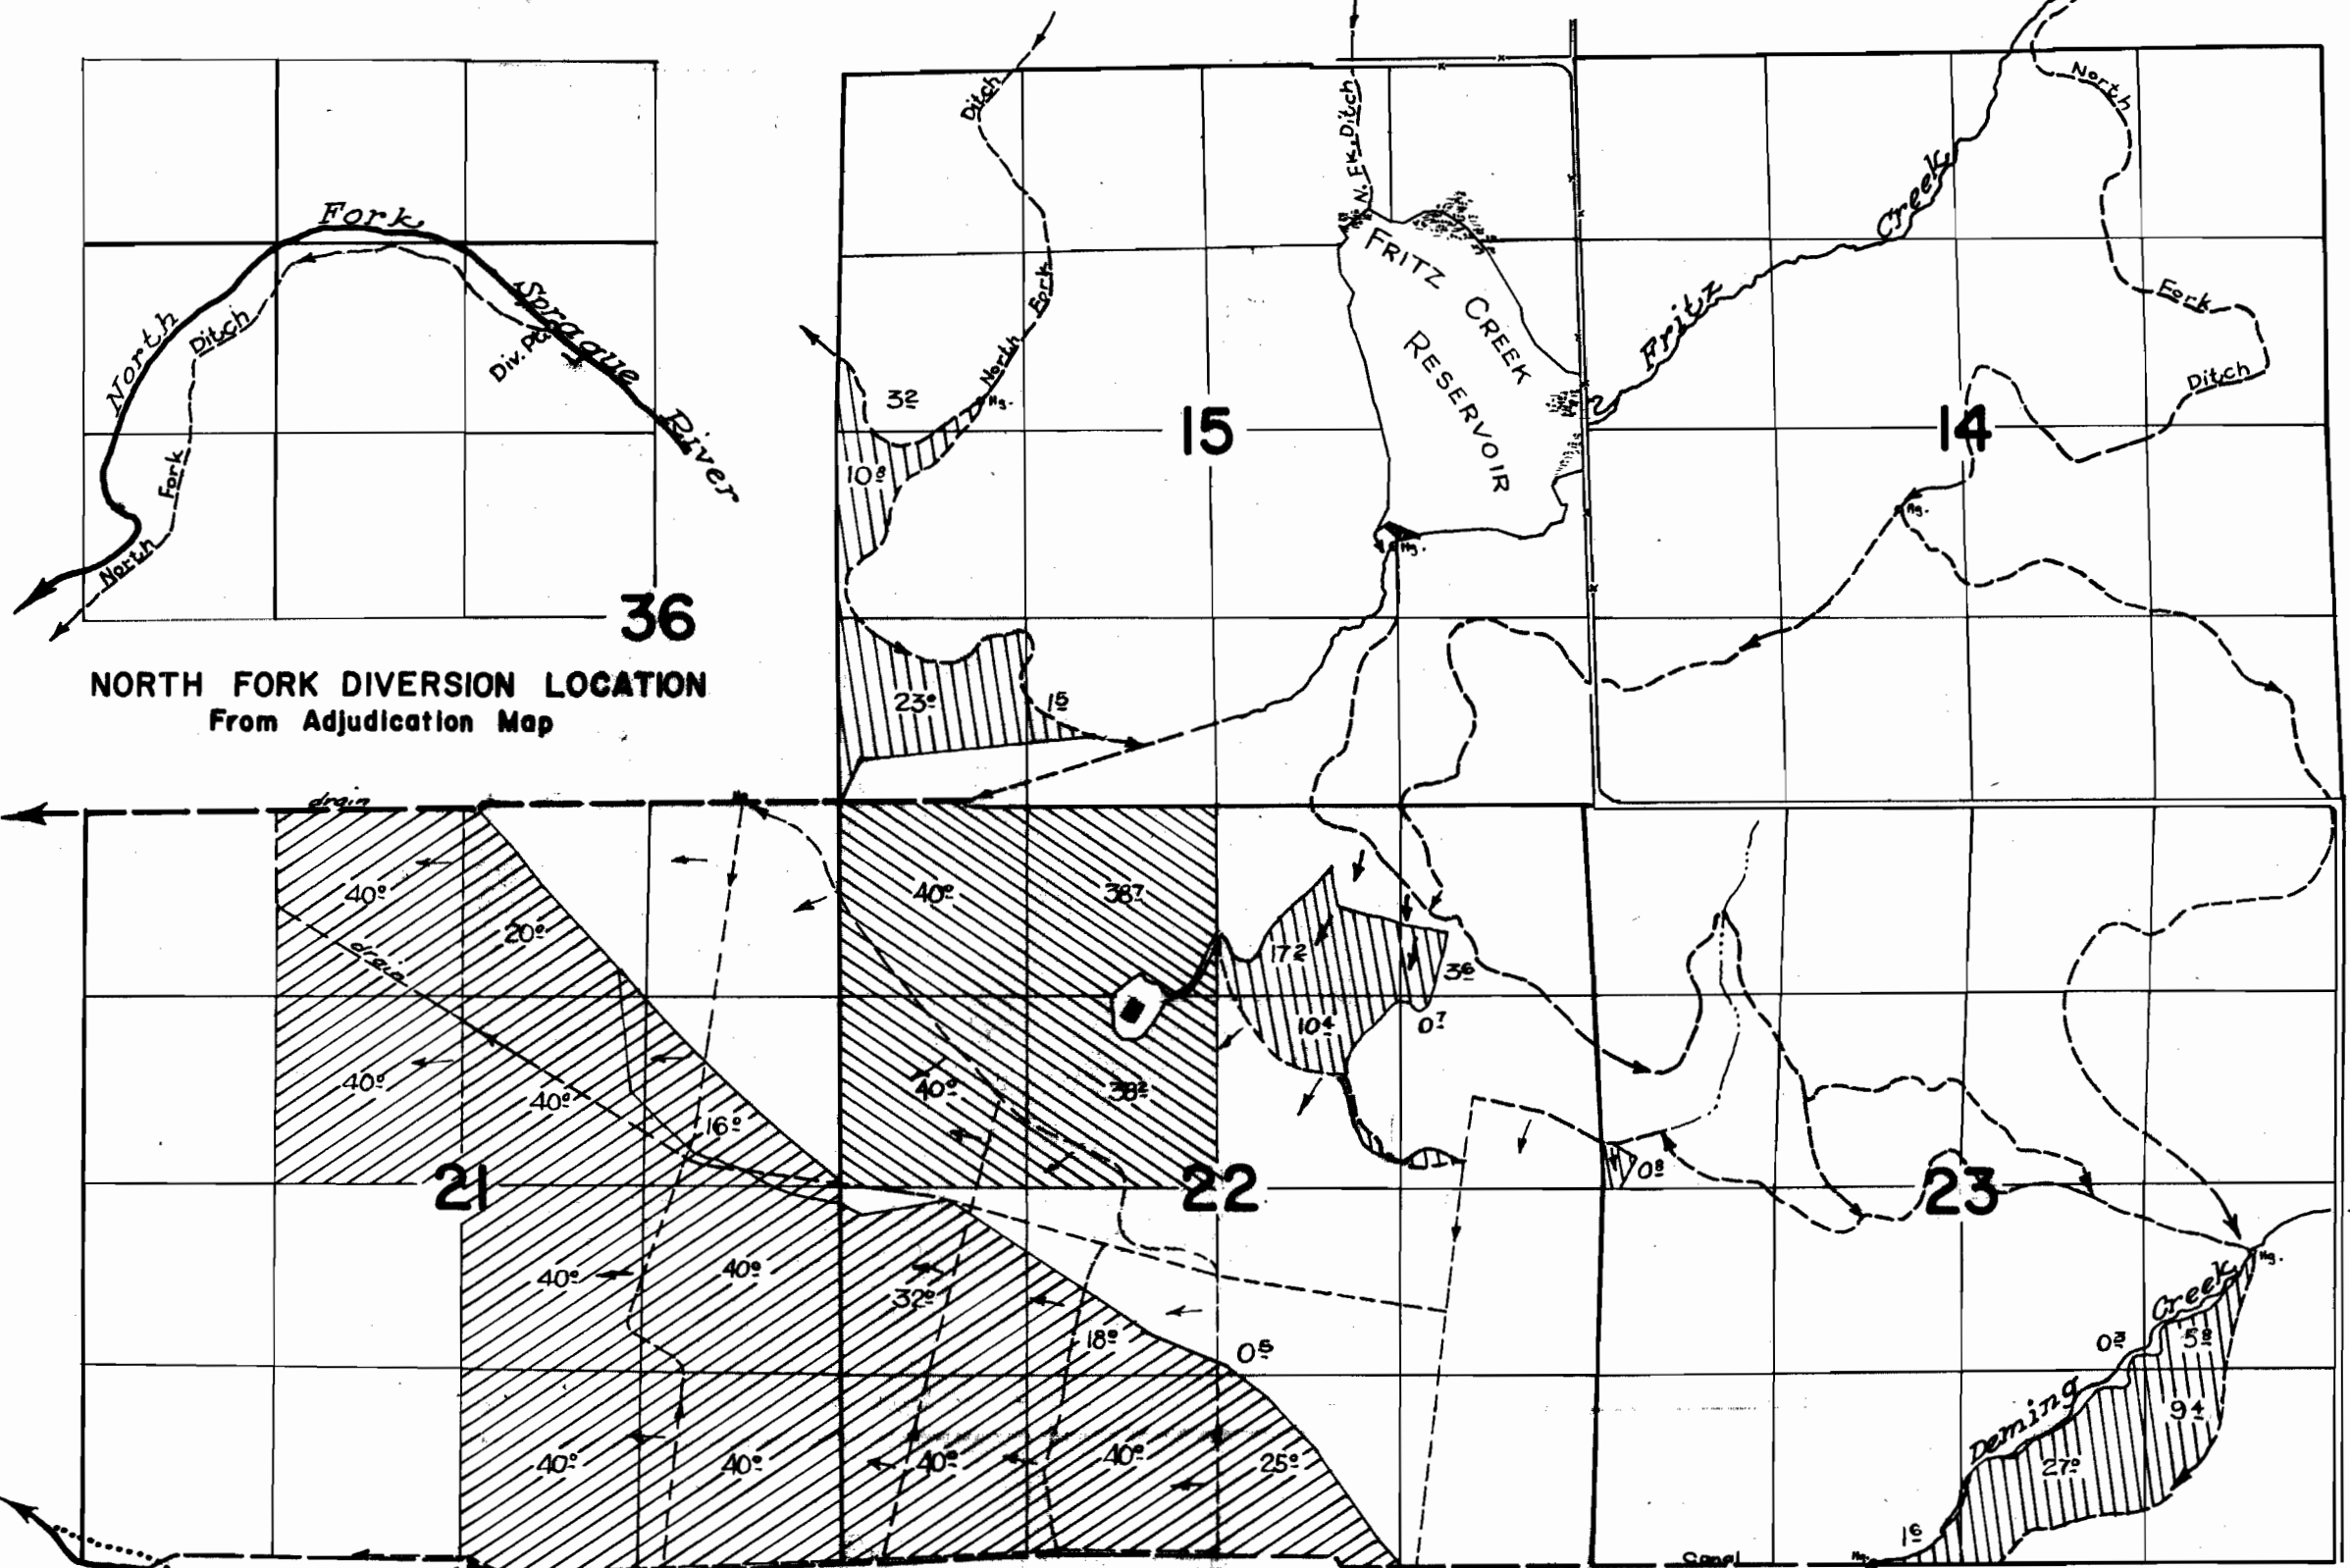

NORTH FORK DIVERSION LOCATION
From Adjudication Map

FINAL PROOF SURVEY

UNDER

Application 25527 Permit 23741

R-28647 R-1553

28648 22565

30526 24036

IN NAME OF

FREDERICK W. & ELIZABETH H. HYDE

Surveyed August 15-16, 1962 by *H. Nelson*

Old Channel
South Fork Sprague R.
Relocated Channel