


G 385

13

31369

T. 27S. R. 15E. W.M.

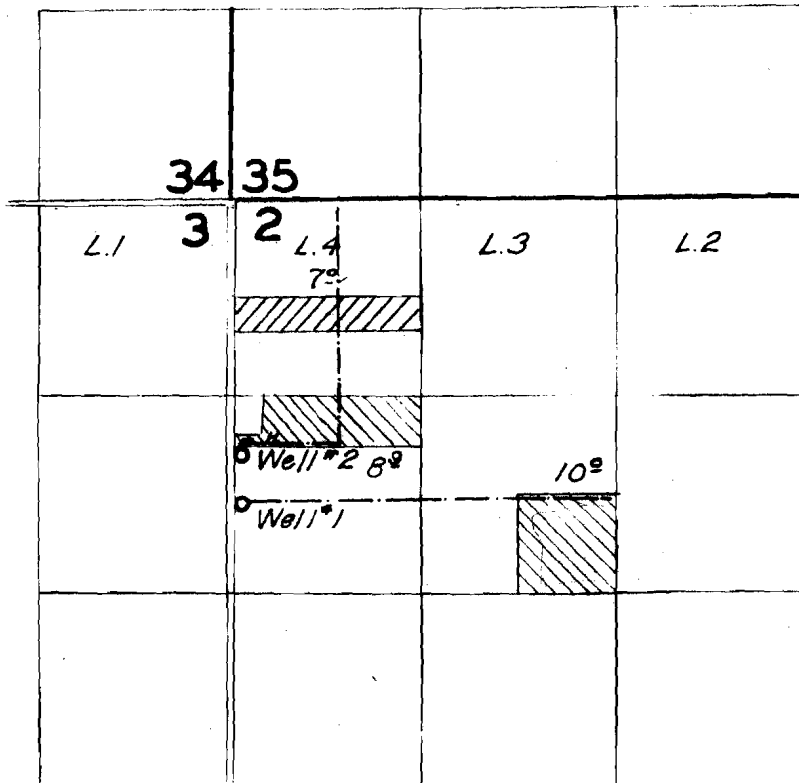

FINAL PROOF SURVEY UNDER

Application No. *G-292* Permit No. *G-385*
IN NAME OF

Charles C. Miles

Surveyed *Sept. 13, 1962*, by *Carl R. Baker*