


G-1275
31371

T.39S.R.19E.W.M.

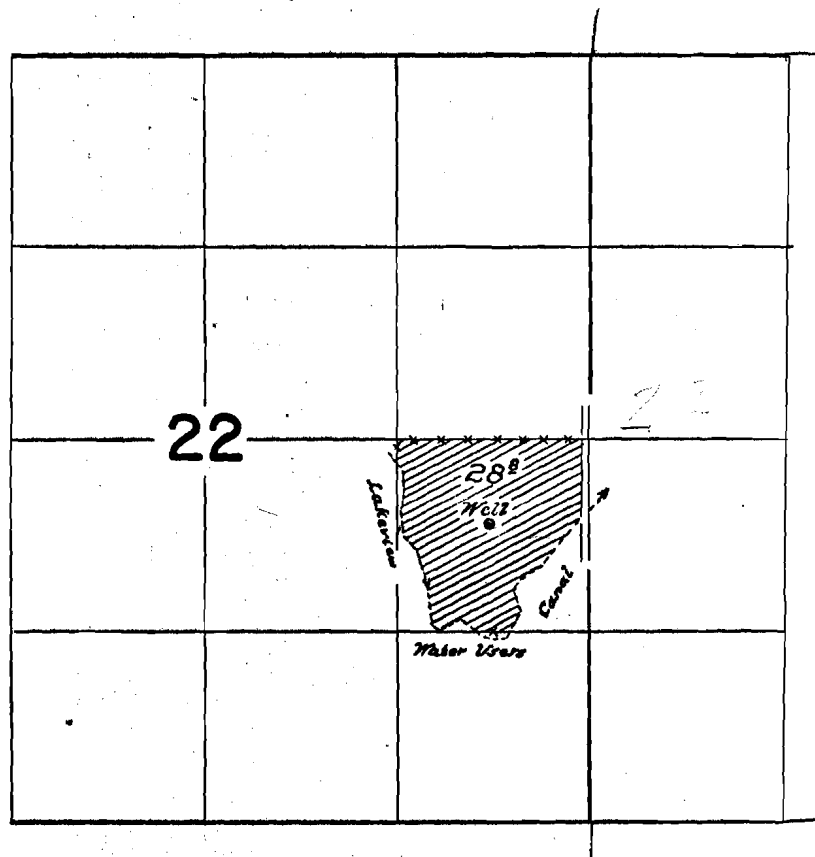

FINAL PROOF SURVEY UNDER

Application No. G-1288 Permit No. G-1275
IN NAME OF

.....
Surveyed Sept. 15 1962, by Thomas P. Lauer