


T.36S.R.25E.W.M.

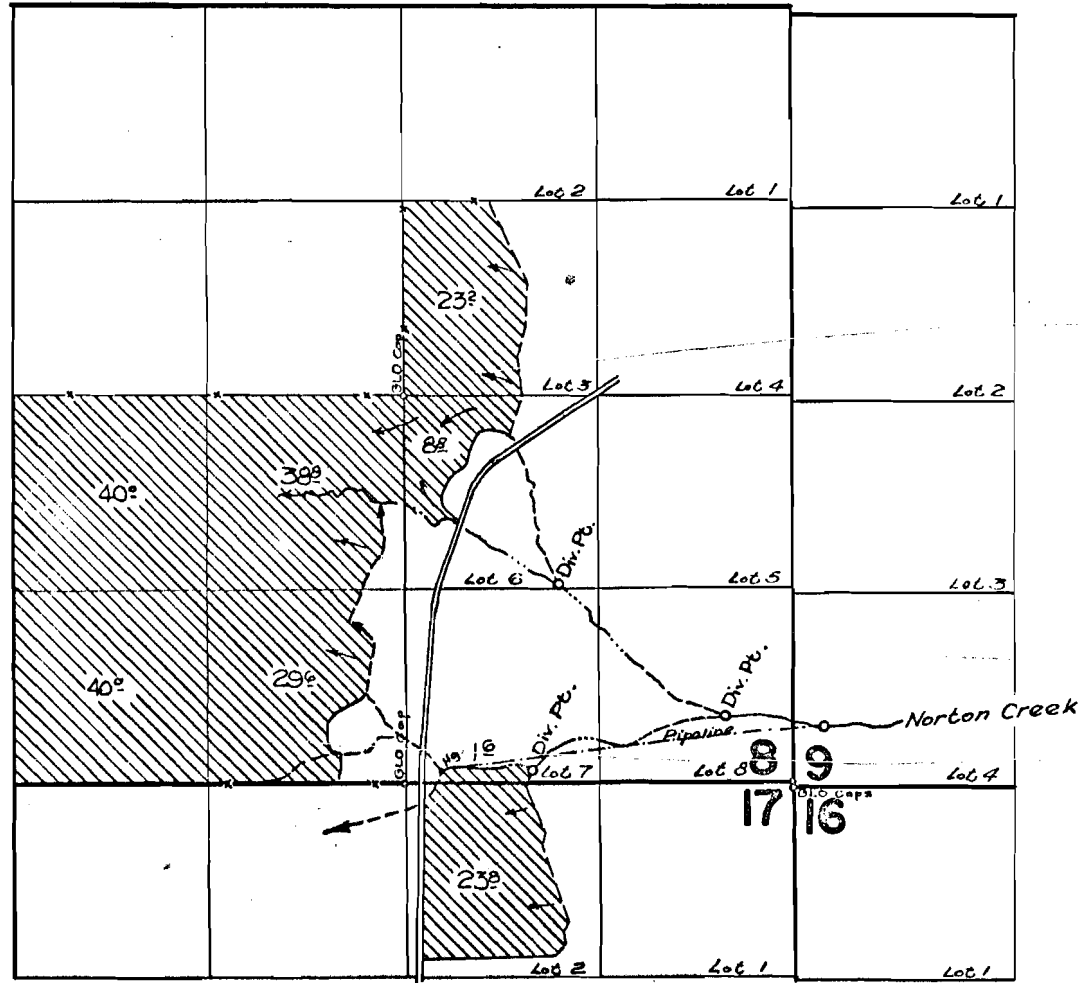

FINAL PROOF SURVEY

UNDER

Application No. 30095... Permit No. 23714.....

IN NAME OF

..... DEESE MCKEE

Surveyed Sept. 12 1962, by *[Signature]*

36-25 ✓