


T.14S.R.39&40E.W.M.

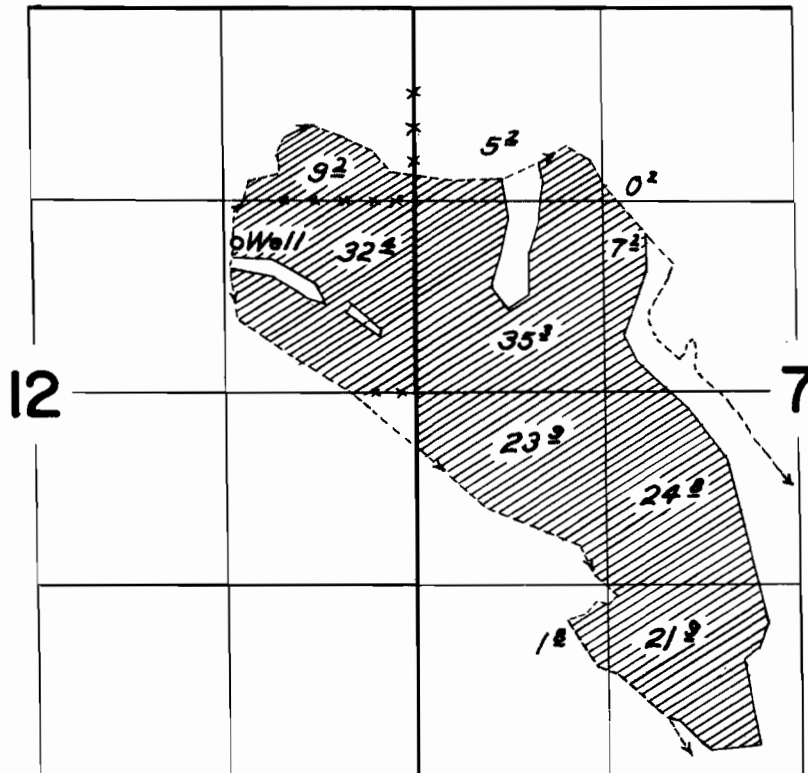

FINAL PROOF SURVEY
UNDER

Application No. U-855 Permit No. U-748
IN NAME OF

R. A. Duncan

Surveyed June 13 1963, by Thomas R. Lauer