


T. 9 S. R. 5 W. W. M.

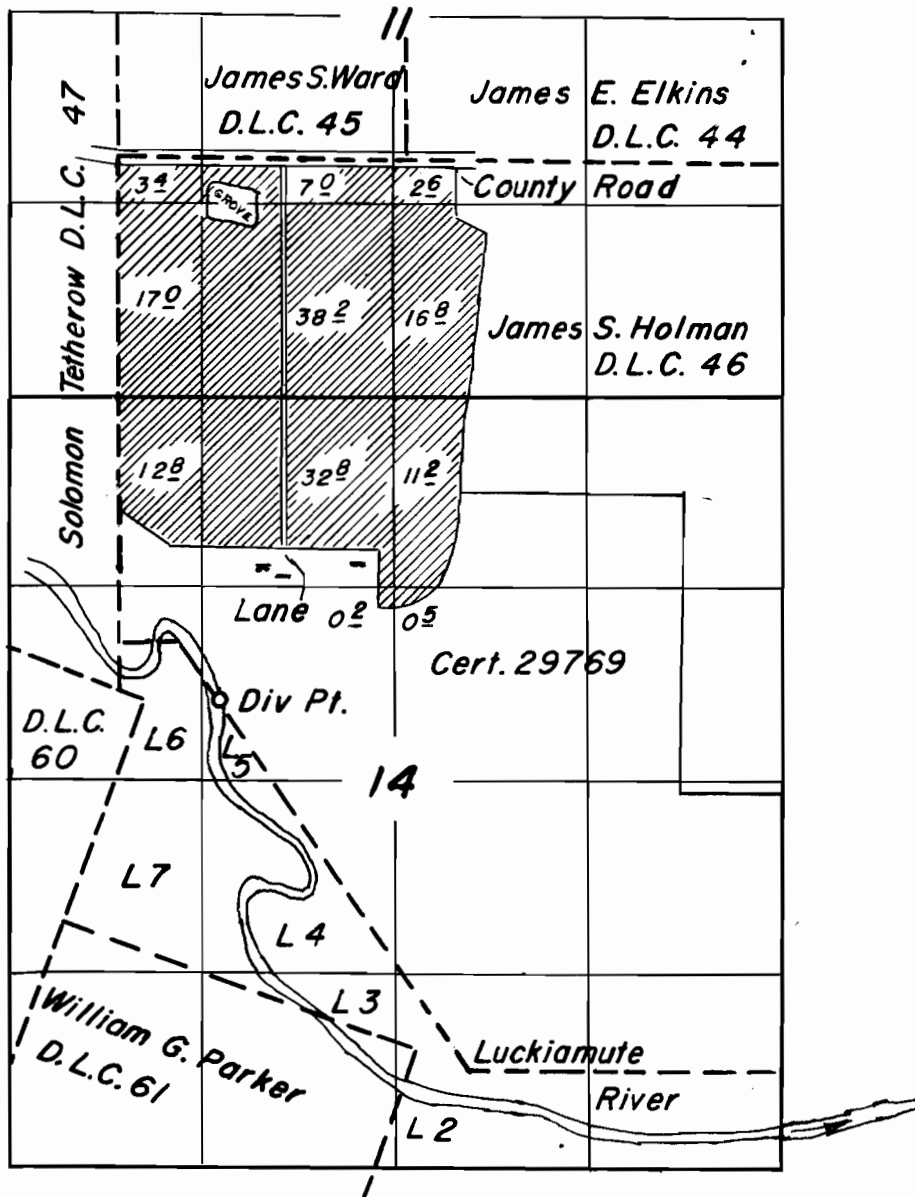

**FINAL PROOF SURVEY**  
UNDER

Application No. 34960. Permit No. 27419  
IN NAME OF


Surveyed Feb. 27 1963, by *Floyd L. Sigmund*