


T. 2 N. R. 17 E. W.M.

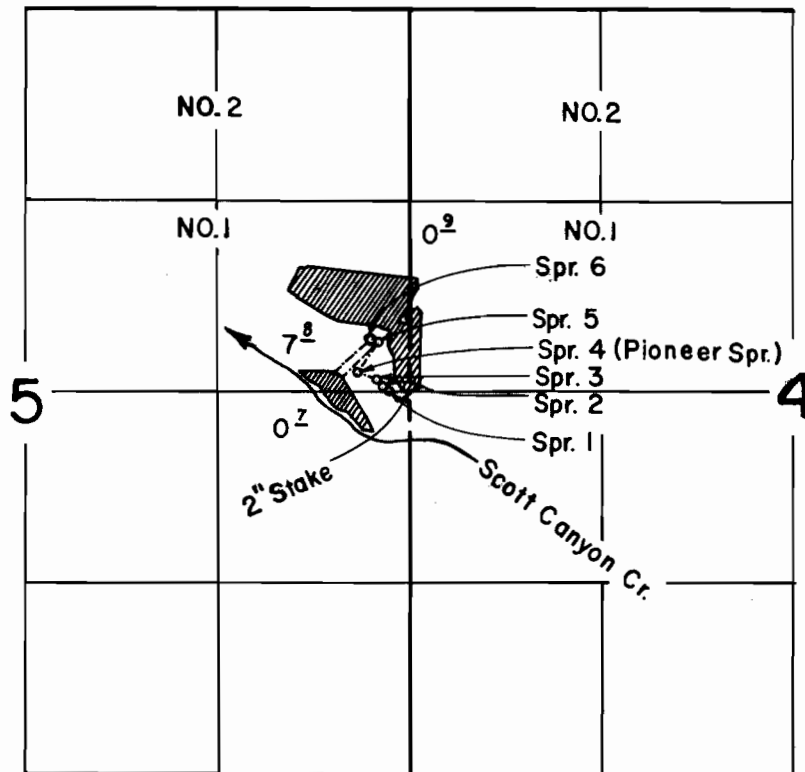

**FINAL PROOF SURVEY**  
UNDER

Application No. 31274... Permit No. 24638..  
IN NAME OF

**ESTATE OF ELIZABETH KUYPERS**

Surveyed June 4, 1962, by *L. W. Jelousch*