


T. 3 N. R. 17 E. W.M.

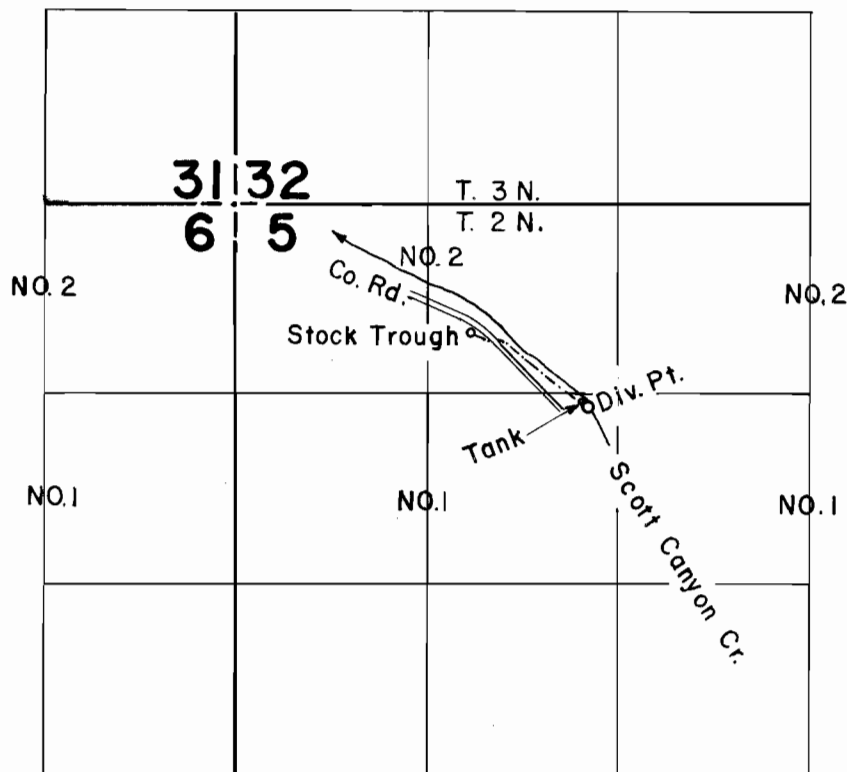

FINAL PROOF SURVEY
UNDER

Application No. 31305 Permit No. 24655
IN NAME OF

T. L. & NELLIE FIELDS

Surveyed June 4, 1962, by *L. W. Joubert*