


T.6N.R.35E.W.M.

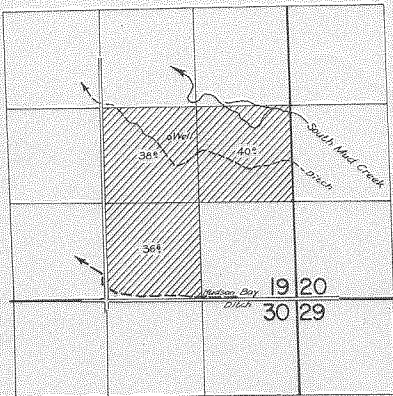

**FINAL PROOF SURVEY**  
UNDER

Application No. G-791 Permit No. G-685  
IN NAME OF

**JOE E. MYERS & EDNA MYERS**

Surveyed April 26 1962, by *Alfredson*