


T.4 S. R. 32 E. W. M.

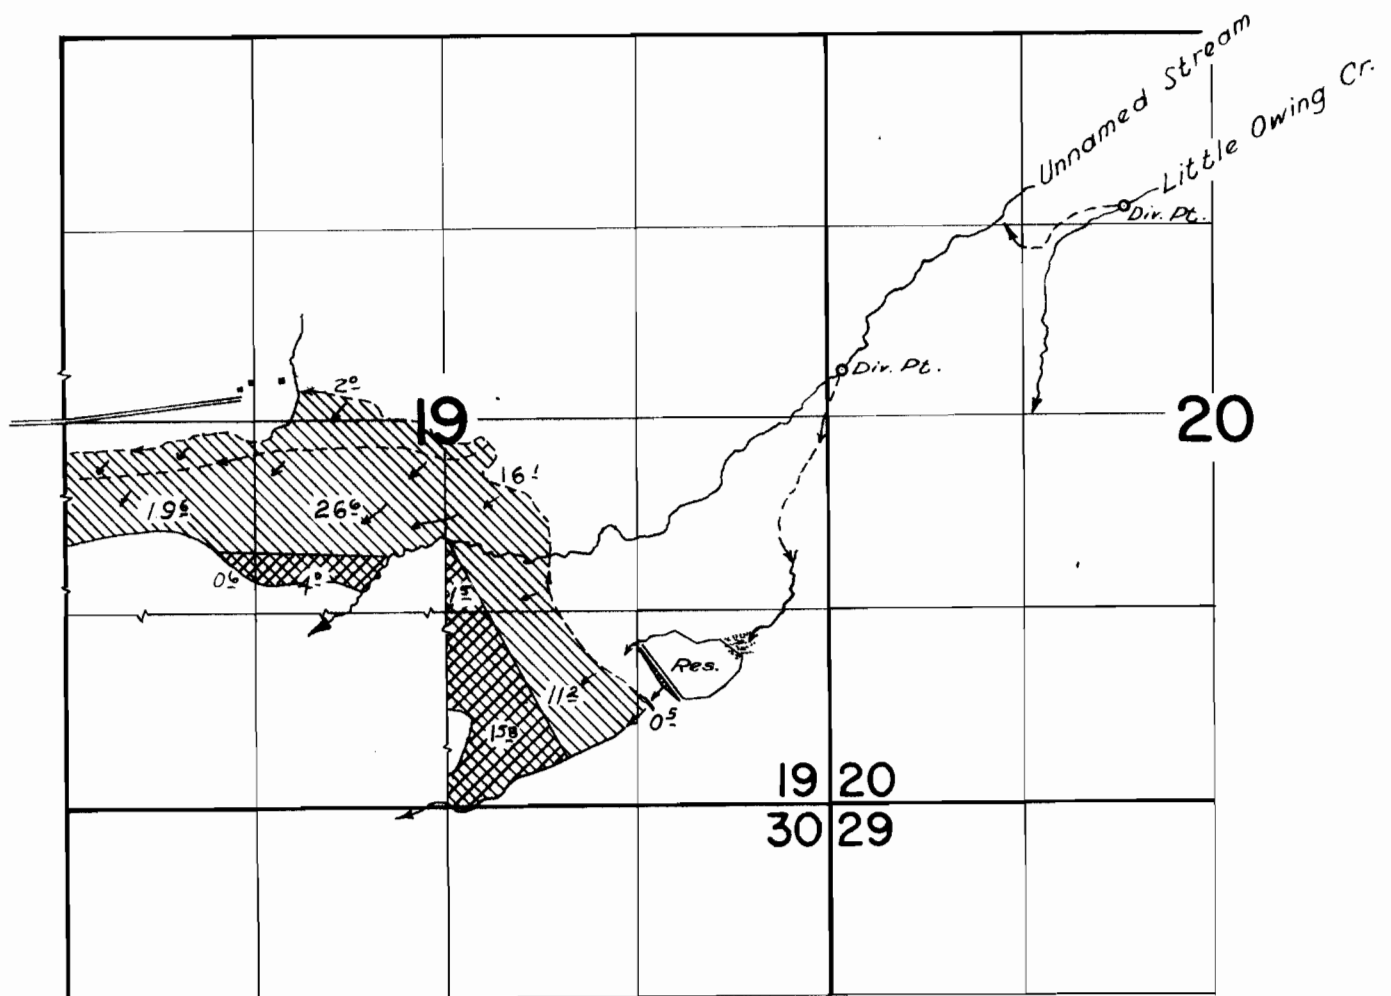

FINAL PROOF SURVEY
UNDER

Application No. **R-31481** **31482** Permit No. **R-2017** **24888**
IN NAME OF

J. P. FRENCH

Surveyed June 11 1962, by *Jefferson*