


T.2S.R.13E.W.M.

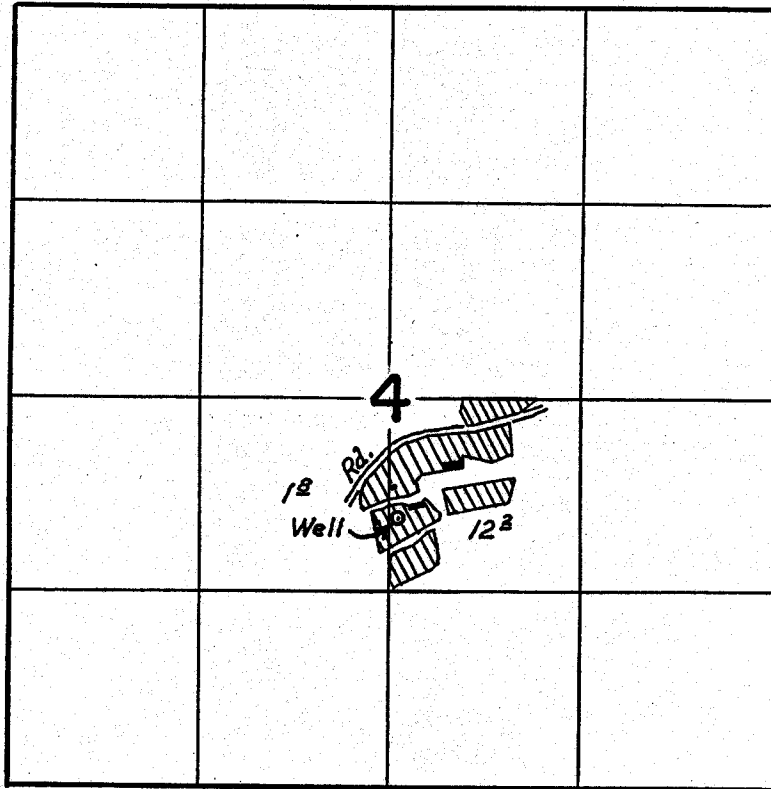

FINAL PROOF SURVEY
UNDER

Application No. G-254 G-1104 Permit No. G-2352 G-951
IN NAME OF

Chase Ranch Company

Surveyed April 18 1962, by Thomas R. Louec