


T.5S.R.14E.W.M.

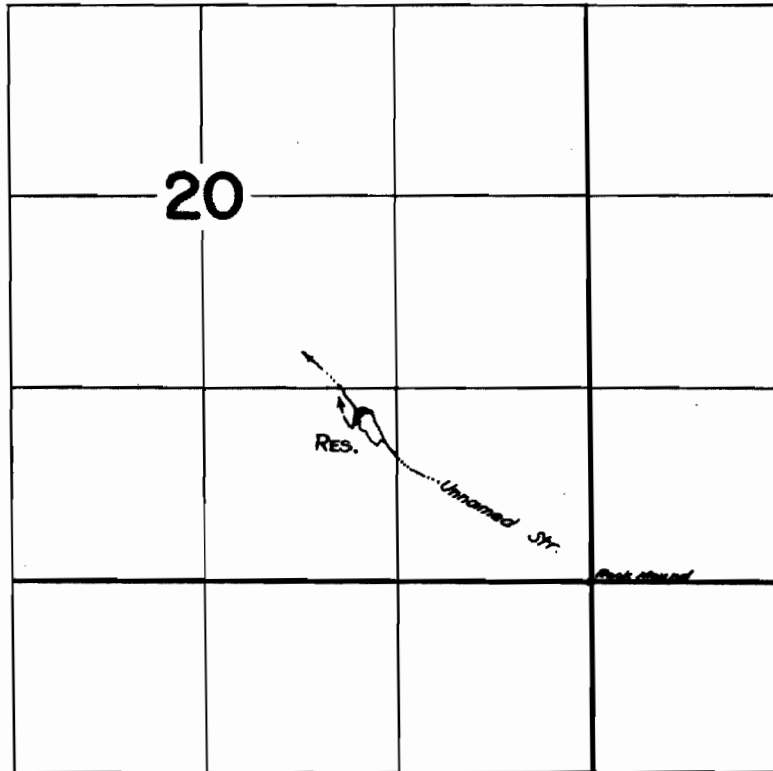

FINAL PROOF SURVEY
UNDER

R-31979 R-2102
Application No. 31980 Permit No. 25239
IN NAME OF

..... VERNE HANNA

Surveyed Oct. 16-30 1962, by *Al Jackson*