


T. 3 N. R. 4 W. W. M.

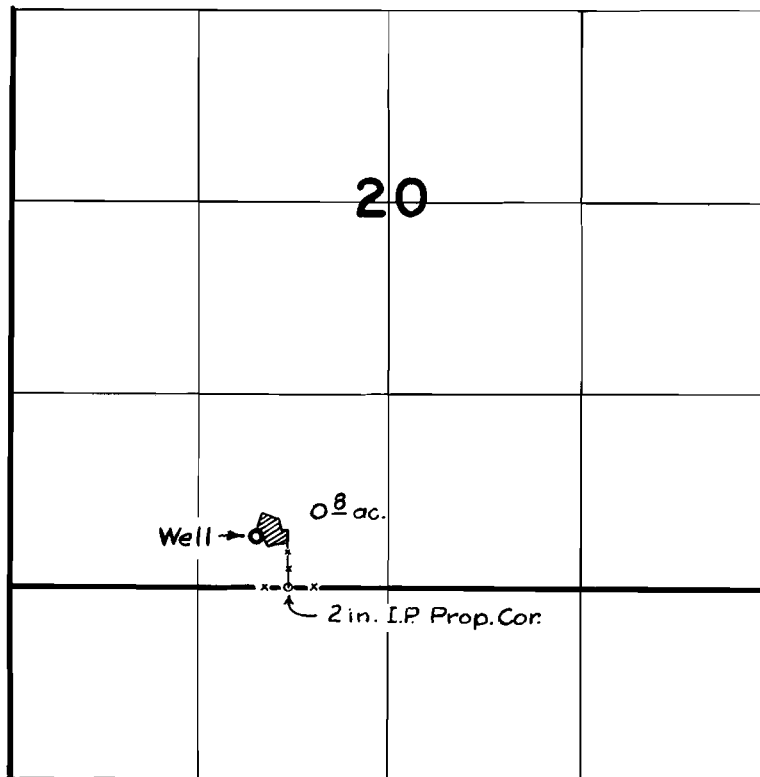

FINAL PROOF SURVEY
UNDER

Application No. G-1910 Permit No. G-1747
IN NAME OF

HAROLD T. SAGDAL

Surveyed 28 June 1962, by M. Bish