


T.2S.R.1W.W.M.

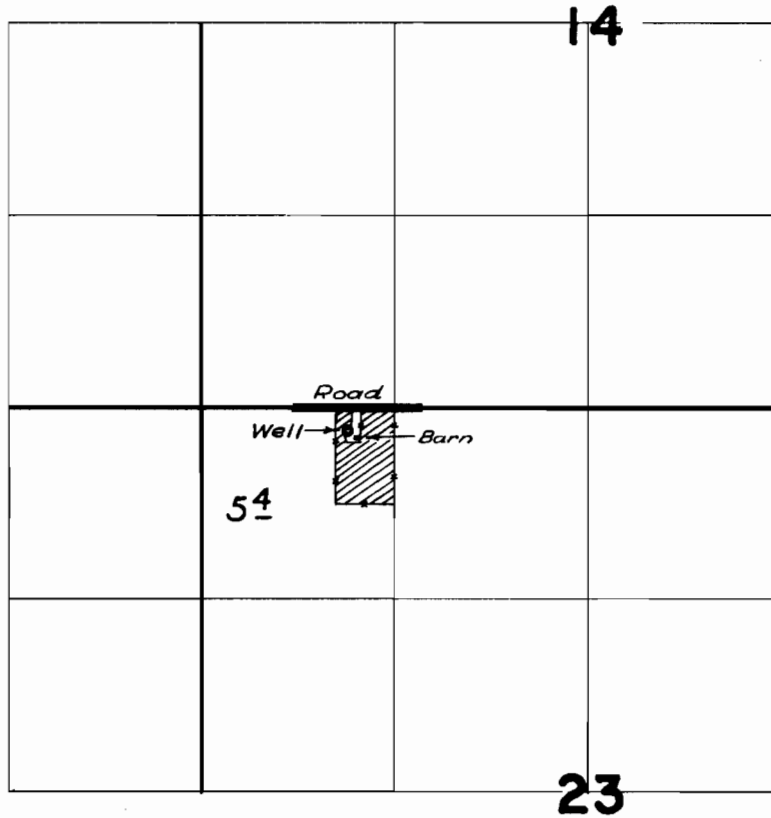

FINAL PROOF SURVEY
UNDER

Application No. G-2231 Permit No. G-2054
IN NAME OF

CLAY BARTON

Surveyed Dec. 24 1962, by M. Bish