


T. 2 S. R. 2 W. W. M.

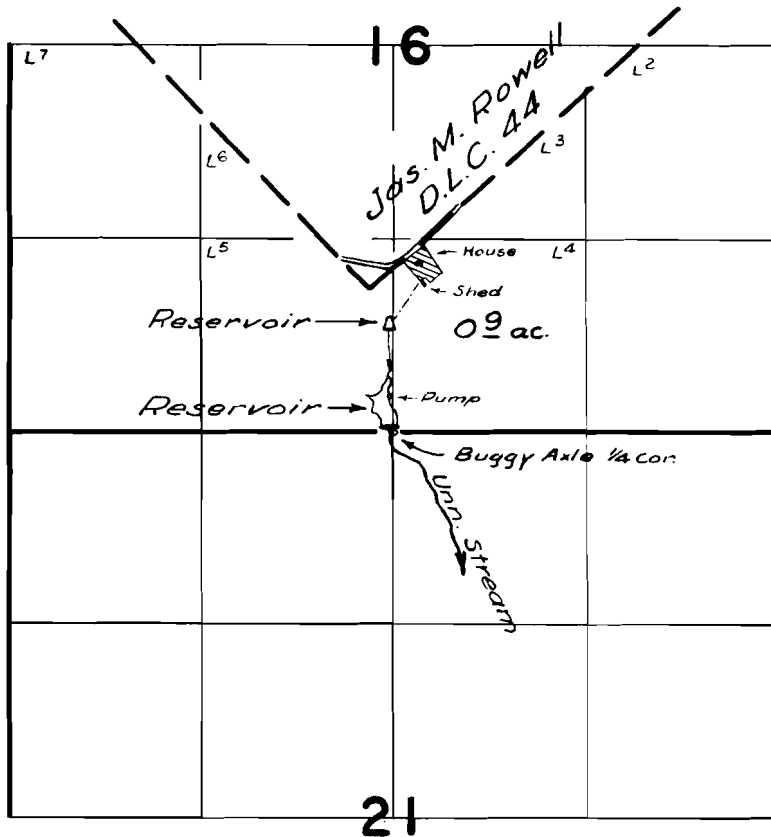

FINAL PROOF SURVEY  
UNDER

R-31827                      R-2069  
Application No. 31828      Permit No. 25102  
IN NAME OF

MELVIN B. WELLS

Surveyed 24 Dec. 1962, by *M. Bishop*