


T.2S.R.2W.W.M.

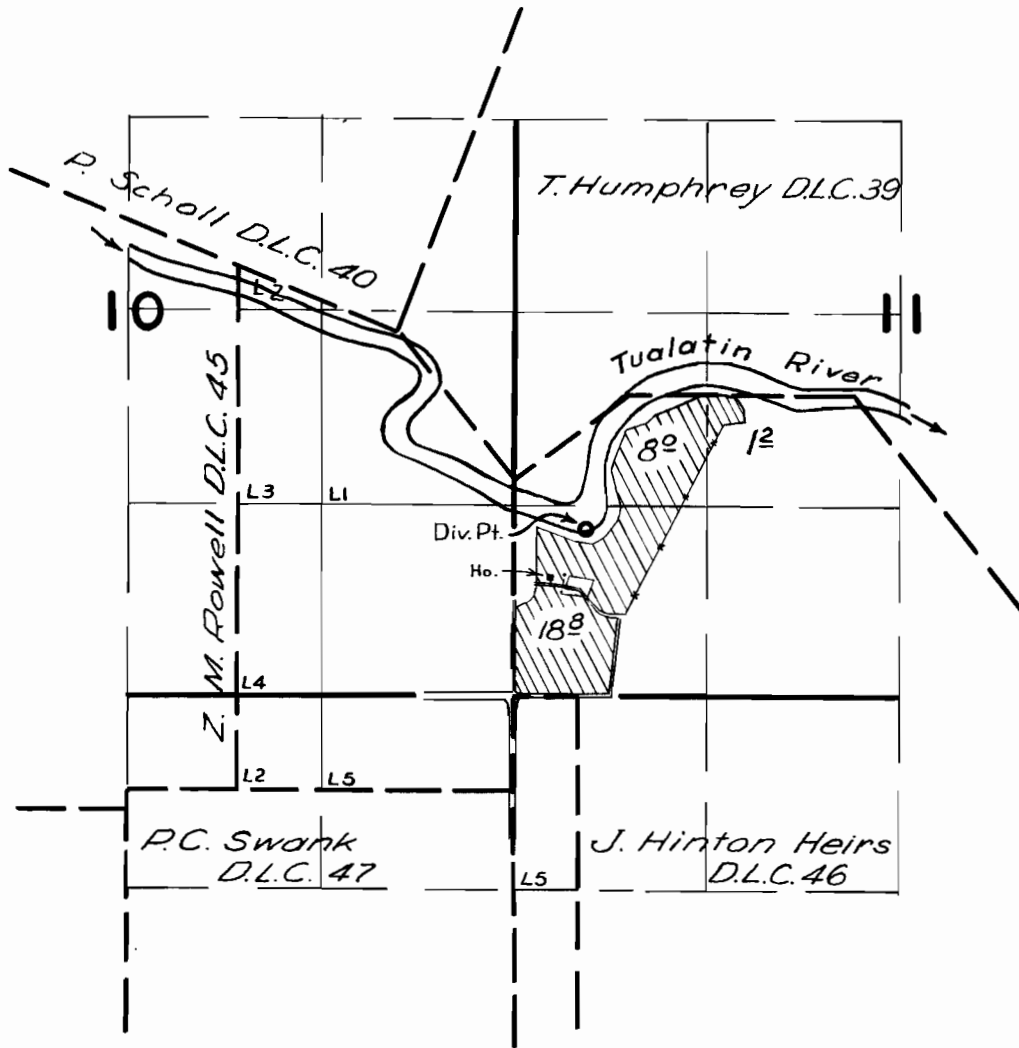

FINAL PROOF SURVEY UNDER

Application No. 32268 Permit No. 25453
IN NAME OF

CLARENCE W. ITEL

Surveyed 20 Aug. 1962, by *F. Bish*