


T. 2. N. R. 2 W. W. M.

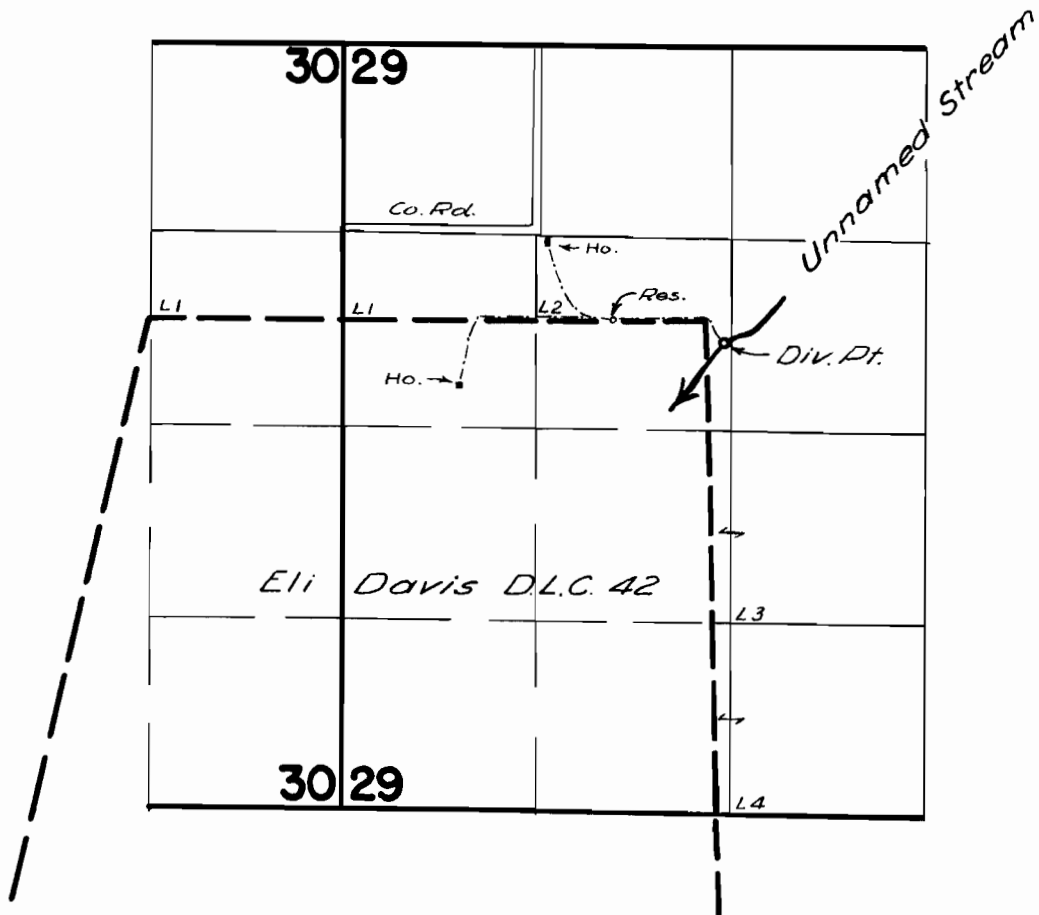

FINAL PROOF SURVEY
UNDER

Application No. 32413 Permit No. 25589
IN NAME OF

EDWIN CONKLIN & GUY GILLETT

Surveyed 22 June 1962, by m. Bish