


T. 3 N. R. 4 W. W. M.

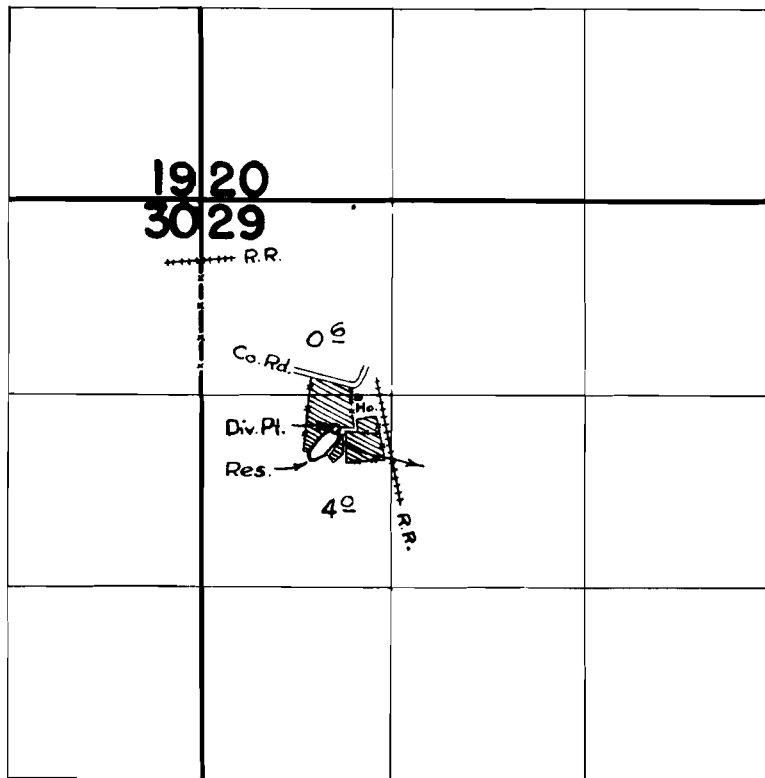

FINAL PROOF SURVEY
UNDER

R-32568 R-2172
Application No. 32399 Permit No. 25670
IN NAME OF

JOHN RINCK

Surveyed 28 June 1962, by M. B. B.