


T. 1 N. R. 4 W. W. M.

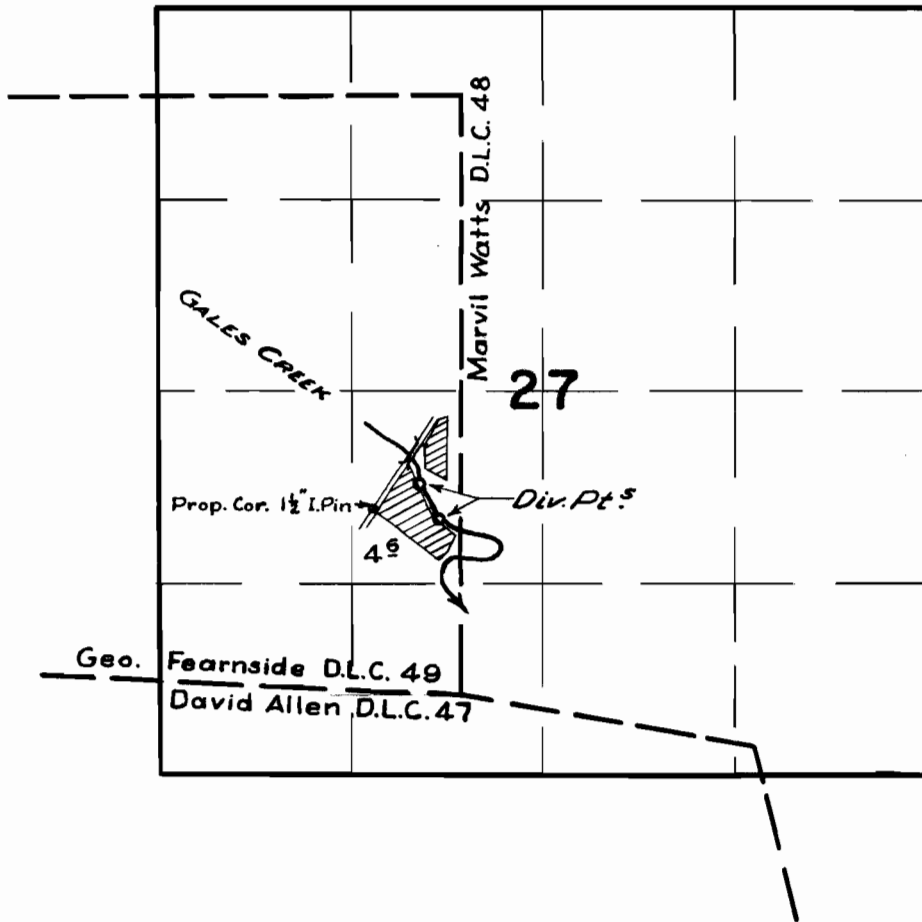

**FINAL PROOF SURVEY**  
UNDER

Application No. 32828 Permit No. 25909  
IN NAME OF

ARTHUR E. MAITLAND

Surveyed 3 July 1962, by Mr. Bish