


T.2N.2W.W.M.

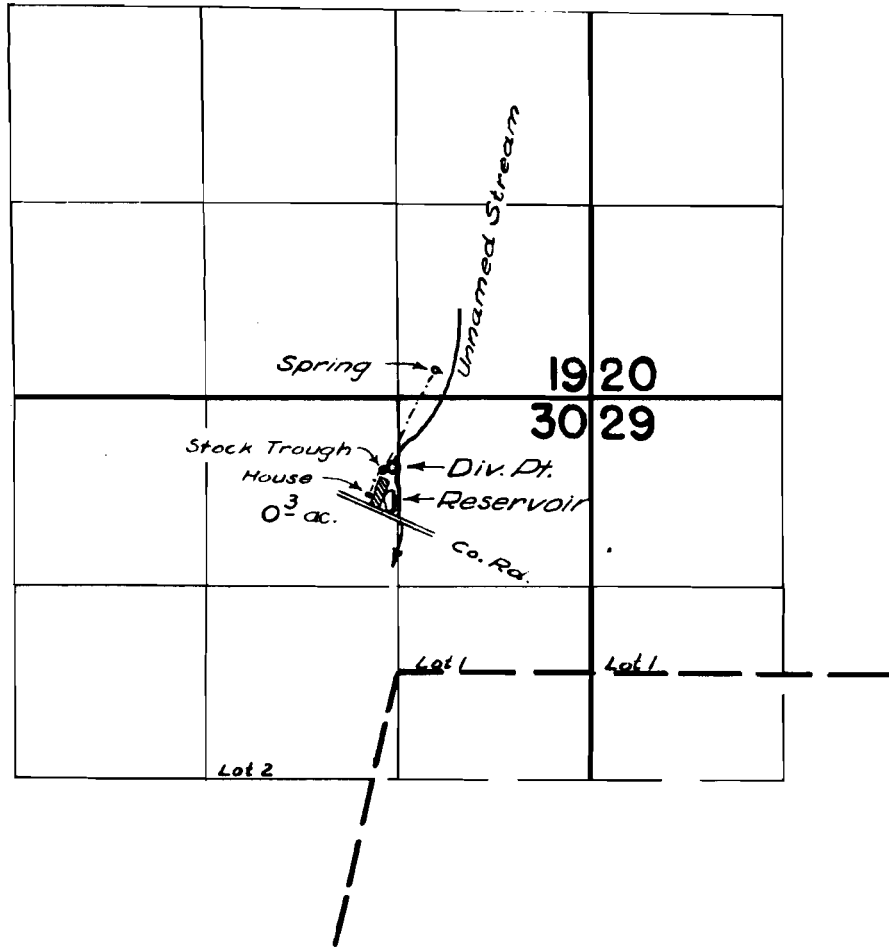

FINAL PROOF SURVEY
UNDER

32956 26043
Application No. R-32955 Permit No. R-2227
IN NAME OF

CHARLES NITCHMAN

Surveyed June 28 1962, by *M. Bish*