


T.2N.2W.W.M.

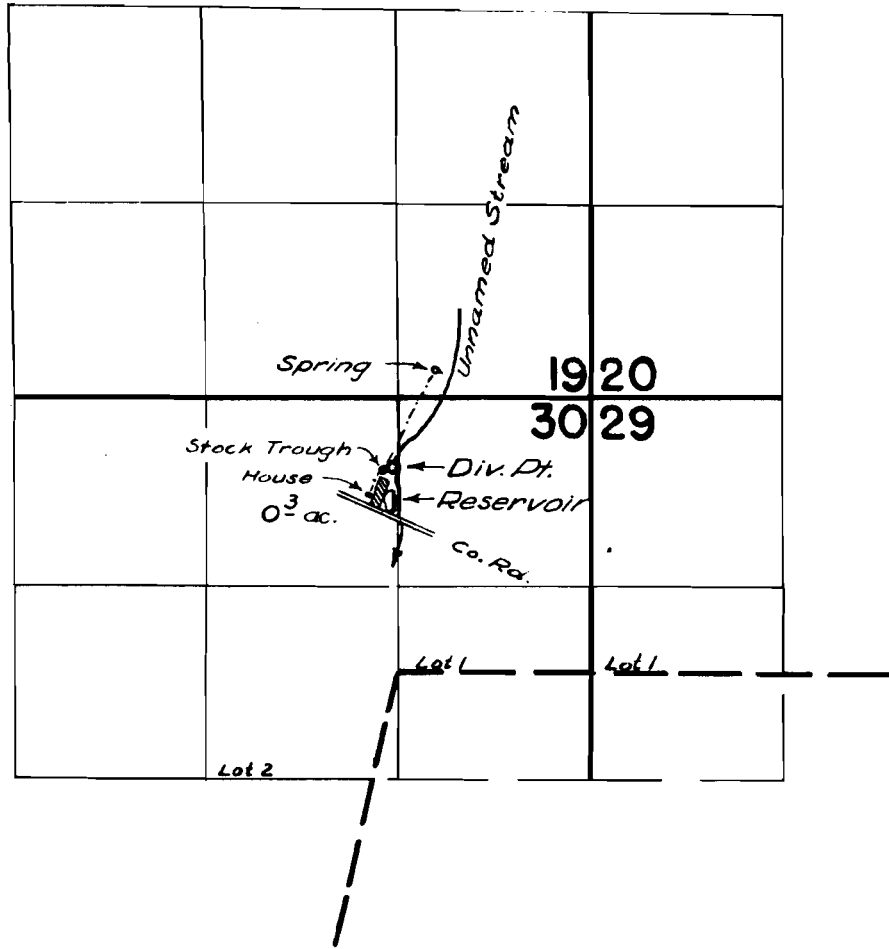

**FINAL PROOF SURVEY**  
UNDER

32956                      26043  
Application No. R-32955 Permit No. R-2227  
IN NAME OF

*CHARLES NITCHMAN*

Surveyed June 28 1962, by *M. Bish*