


T.3N.R.5W.W.M.

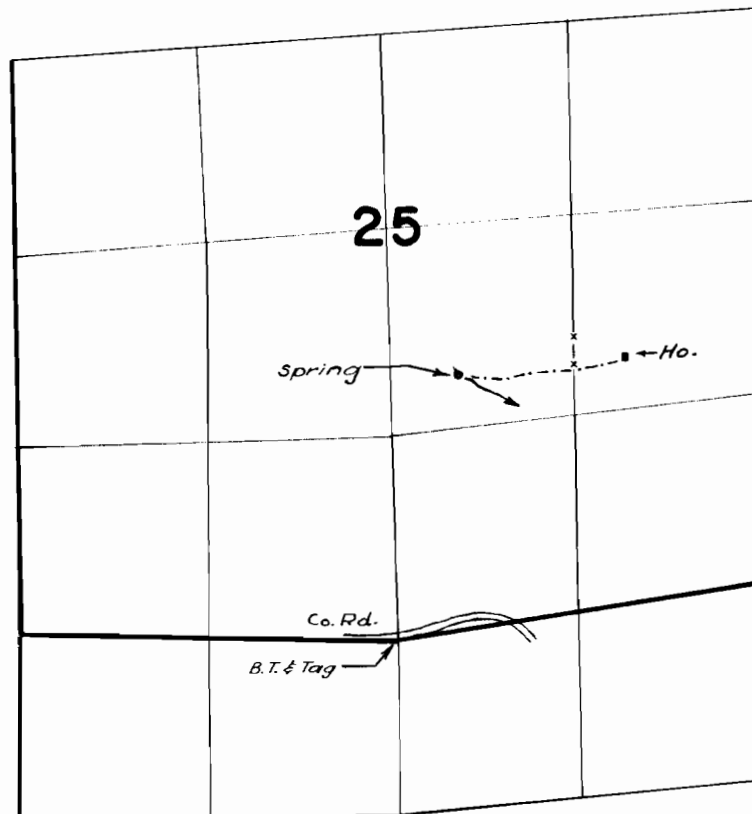

FINAL PROOF SURVEY
UNDER

Application No. 34129 Permit No. 26930
IN NAME OF

LILLIAN STRASSEL

Surveyed 26 June 1962, by M. Bish