


T.2N.R.3&4W.W.M.

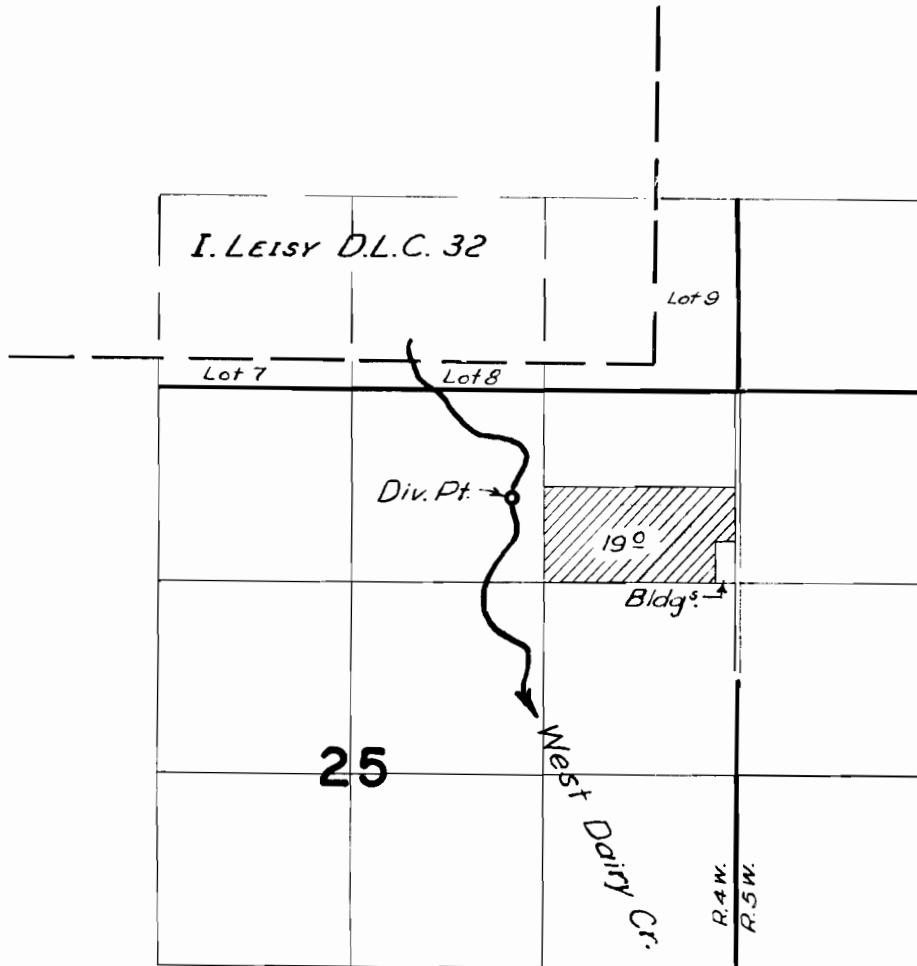

FINAL PROOF SURVEY
UNDER

Application No. 34614 Permit No. 27179..
IN NAME OF

VERLE E. PRICKETT

Surveyed 3 July 1962, by M. Bish