


T.7S, R.19E.W.M.

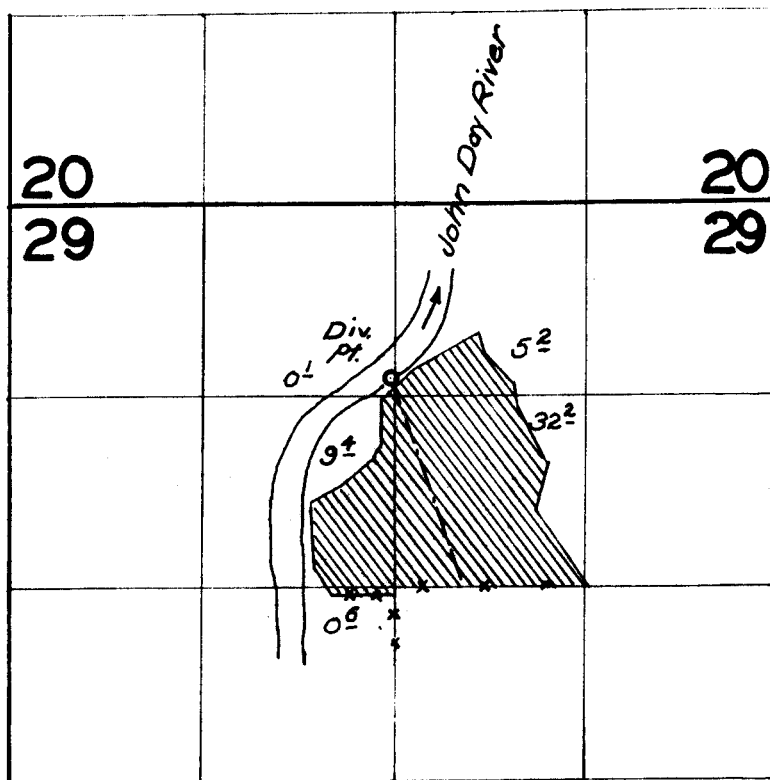

FINAL PROOF SURVEY UNDER

Application No. *28489* Permit No. *22498*
IN NAME OF

.....
Surveyed *Sept. 26, 1962*, by *Ralph Jackson*