


T.5S.R.3W.W.M.

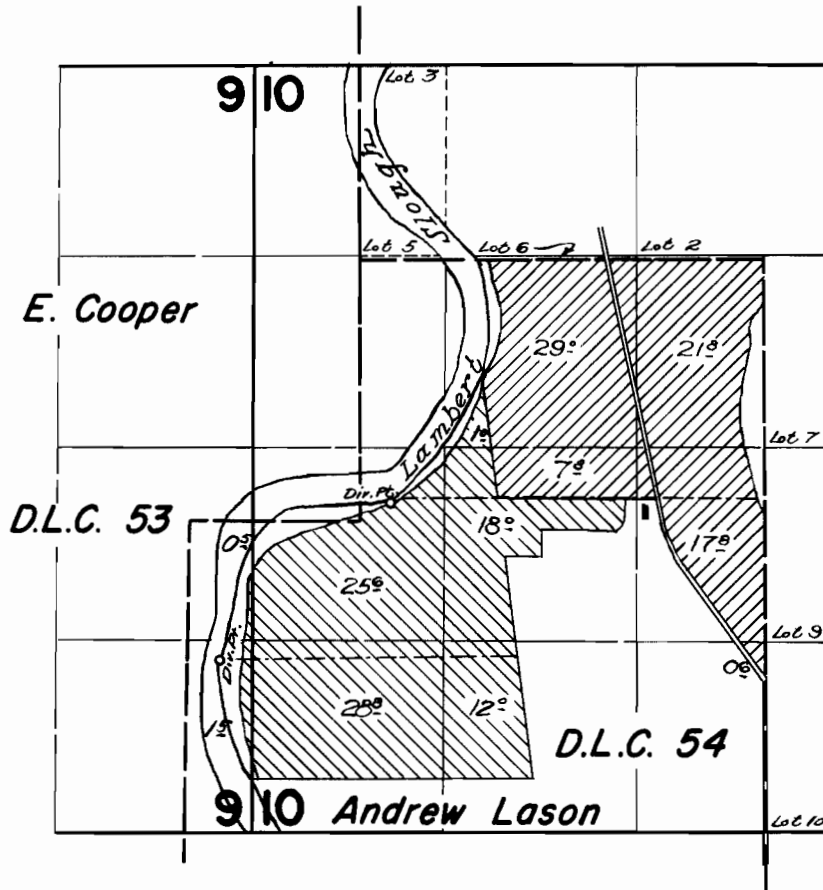

FINAL PROOF SURVEY UNDER

Application No. **32539** Permit No. **25827** 
34716 Permit No. **27259** 
IN NAME OF

FRANK FINNICUM

Surveyed August 29 1962, by *R. Jackson*